

HARRISON
 0210
 7-10-70

MISSISSIPPI
 BOARD OF WATER COMMISSIONERS
 416 North State Street
 Jackson, Mississippi 39201
 WATER WELL DRILLERS LOG

CODED

7-10 1970 Q.T. Switzer Well Co. HARRISON
 date well completed firm name county well located

LANDOWNER: E.E. Woodfield
Clondike Road
Long Beach, Miss.
 (mailing address)

WELL LOCATION:
 sec 11 T. 8 N R. 12 E
2 miles N of LONG BEACH
 (distance) (direction) (nearest town)

WELL PURPOSE: HOME
 (home, irrigation, municipal, industrial)

WELL COMPLETION DATA:

(1) diameter (inches) 4"

(2) total depth (feet) 753'

(3) static water level (feet) -9' below top of ground above

(4) casing galv. 753'
 (material) (depth)
 (size) if telescope see back.

(5) screen 40' 713'
 (length) (depth to top)
008 STAINLESS STEEL
 (size) (material)

(6) pump 3 25
 (HP) (yield gpm)
ELEC.
 (type power)

(7) electric log NO
 (yes or no)

(organization running log)

(8) how well bottom plugged back
PRESSURE VALVE

description of formations encountered	from	to
brass sand	1	20
sand + gravel	20	40
clay	40	55
sand	55	60
clay	60	138
mixed	138	158
sand streak	158	178
mixed	178	197
clay	197	238
sand streak	238	258
clay	258	337
sand	337	382
clay	382	397
fine sand	397	409
clay	409	436
clay + shale	436	456
clay	456	468
sand	468	476
clay	476	509
sand	509	527
clay	527	529
sand	529	535
clay	535	554
mixed	554	574
clay	574	613
shale	613	633
clay	633	653
shale	653	673
sand, good	673	753

CODED


SEP 11 1970

DRILLERS REMARKS:

MISS. BD. OF
 WATER COMMISSIONERS

If well telescopes please sketch and show depths.

GROUND LEVEL

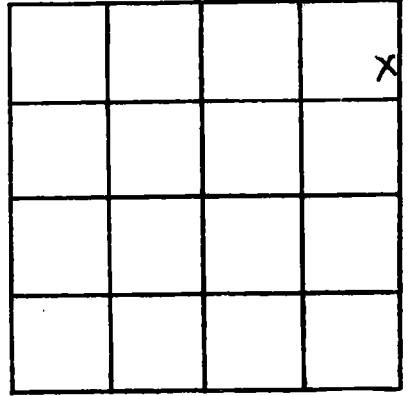

SECTION 11

Please indicate well location X.

ADDITIONAL INFORMATION

Lined area for additional information.

If more than one screen, show locations of each on sketch.