

HARRISON
Ø 216
4-24-70

MISSISSIPPI
 BOARD OF WATER COMMISSIONERS
 416 North State Street
 Jackson, Mississippi 39201

CODED

WATER WELL DRILLERS LOG

April 24 1970 McGill Well Works HARRISON
 date well completed firm name county well located

LANDOWNER: Earl N. Mohler

Rt. 1, Box 103
Long Beach Miss.
 (mailing address)

WELL LOCATION:

sec. 4 T 8 N R 12 E
4 miles East of Long Beach
 (distance) (direction) (nearest town)

WELL PURPOSE: Home
 (home, irrigation, municipal, industrial)

WELL COMPLETION DATA:

- (1) diameter (inches) 2"
- (2) total depth (feet) 550'
- (3) static water level (feet) 1" below
 top of ground above
- (4) casing galv
 (material) (depth)
- 10' If telescope see back.
 (size)
- (5) screen 10' 540
 (length) (depth to top)
- 2" S.S.
 (size) (material)
- (6) pump - Elwing
 (HP) (yield gpm)
- (type power)
- (7) electric log -
 (yes or no)
- (organization running log)
- (8) how well bottom plugged Sand
Shark

description of formations encountered

from to

clay	0'	25'
sand	25'	75'
pipe clay	75'	130'
mud	130'	350'
sand	350'	385'
pipe clay	385'	425'
SAND	425'	550'

CODED


AUG 14 1970

DRILLERS REMARKS:

MISS. BD. OF
 WATER COMM.

If well telescopes please sketch and show depths.

GROUND LEVEL

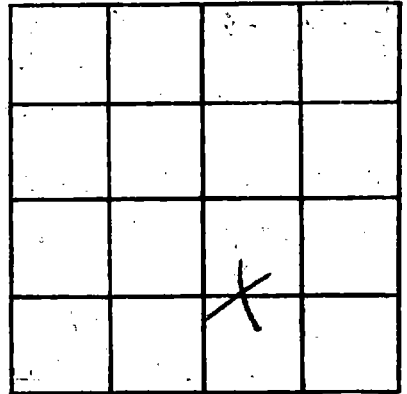

SECTION 4

Please indicate well location X.

ADDITIONAL INFORMATION

If more than one screen,
show locations of each on sketch.