

HARRISON  
Ø 218  
9-6-70

MISSISSIPPI  
 BOARD OF WATER COMMISSIONERS  
 416 North State Street  
 Jackson, Mississippi 39201

**CODED**

WATER WELL DRILLERS LOG

Sept. 6 1970 Mc Nee Well Works Harrison  
 date well completed firm name county well located

LANDOWNER: John Smith  
Ret., Box 108-A  
Long Beach Miss.  
 (mailing address)

description of formations encountered	depth	
	from	to
clay	0	30
sand	30	80
clay	80	110
shell	110	360
sand	360	400
fine sand	400	480
sand	480	525

WELL LOCATION:  
 sec. 4 T 8 N R. 12 E  
3 miles W of Long B.  
 (distance) (direction) (nearest town)

WELL PURPOSE:  
 (home, irrigation, municipal, industrial)

- WELL COMPLETION DATA:
- (1) diameter (inches) 2"
  - (2) total depth (feet) 525'
  - (3) static water level (feet) 16" below above top of ground.
  - (4) casing galvanized  
 (material) (depth)  
used if telescope see back.  
 (size)
  - (5) screen 10', 5/5  
 (length) (depth to top)  
2", 5.5.  
 (size) (material)
  - (6) pump 1 19  
 (HP) (yield gpm)  
electric  
 (type power)
  - (7) electric log —  
 (yes or no)  
—  
 (organization running log)
  - (8) how well bottom plugged sand  
shell

**CODED**


JAN 27 1971

DRILLERS REMARKS:

MISS. Bd. of  
 WATER LOG

If well telescopes please sketch and show depths.

GROUND LEVEL

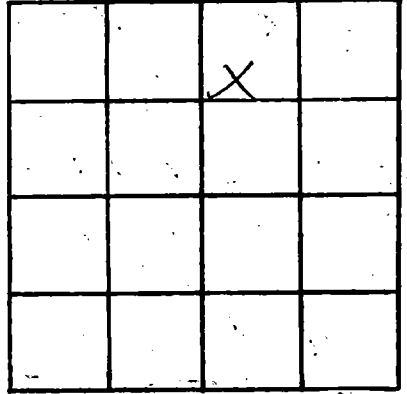

SECTION 4

Please indicate well location X.

ADDITIONAL INFORMATION

If more than one screen, show locations of each on sketch.