

Φ 220 L 274610
12-62

WATER WELL DRILLERS LOG

CODED

Date: Dec, 1962, Driller: Joe Miller County Harrold
(Name)

		Description & Color of Materials Sand, Clay, Red Clay, Shell, etc.	Thick- ness Feet	Depth Feet
(1) Owner of Land: <u>Alphon Covas</u> (Name)		<u>White Clay,</u>	<u>23</u>	<u>23</u>
<u>RR# Pass Christian Miss.</u> (Address)		<u>Blue Clay,</u>	<u>118</u>	<u>142</u>
(2) Location: <u>1/4</u> , <u>1/4</u> , Sec. <u>14</u> T <u>8</u> R <u>12</u>		<u>Blue Gray Sand (fine)</u>	<u>14</u>	<u>156</u>
<u>8</u> miles <u>North</u> , of <u>Pass Christian</u> (distance) (direction) (Nearest Town)		<u>Blue Clay</u>	<u>109</u>	<u>265</u>
(3) Topography: <u>Hilly</u> (Hilly) (Flat) (Level)		<u>Sua Sand. (fine)</u>	<u>19</u>	<u>284</u>
(4) Purpose of Well: <u>Domestic</u> (Domestic Irrigation Municipal, Industrial, Other)		" " <u>Fine</u>	<u>10</u>	<u>294</u>
		" " <u>Good</u>	<u>11</u>	<u>305</u>
		" " <u>Good</u>	<u>8</u>	<u>313</u>
		<u>Had Blue Clay.</u>	<u>1</u>	<u>314</u>

Information upon completion of well:


- (1) Diameter 2" inches.
- (2) Total Depth 315' feet.
- (3) Water Level 27' feet below top of ground.
- (4) Cased to 302', Size 2"
- (5) Screen: Size 2", Length 10'
- (6) Were any formations sealed against pollution?
_____ yes, _____ no.

If YES depth of formation _____

Why _____

Drillers Remarks: _____

CODED

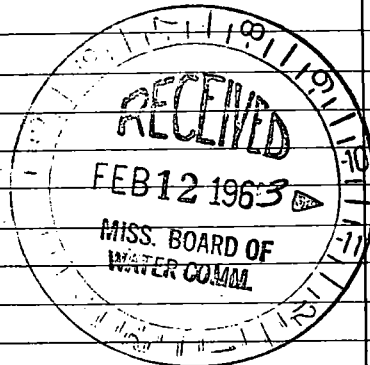

over

(Use Back Side)

Well No.

1940

Pineville Road

Bay St Louis

Wolf River

