

CODED

J-311

HAR.

0622

E967309

WATER WELL DRILLERS LOG

Date: 3/19, 1962, Driller: H. G. Ladner County Harrison

3-19-62

(Name)

(1) Owner of Land: <u>Mrs D.P. Randall</u> (Name)	Description & Color of Materials Sand, Clay, Red Clay, Shell, etc.	Thick- ness Feet	Depth Feet
<u>Espy Ave</u> (Address) #10 B. 12	<u>yellow clay</u>	<u>20</u>	
	<u>white sand</u>	<u>10</u>	
(2) Location: <u>1/4</u> , <u>1/4</u> , Sec 15 <u>12</u>	<u>Blue clay</u>	<u>20</u>	
<u>2</u> miles <u>Southwest</u> of <u>Pineville</u> (distance) (direction) (Nearest Town)	<u>Blue clay fine sand</u>	<u>20</u>	
	<u>Blue sand</u>	<u>30</u>	
(3) Topography: <u>Level</u> (Hilly) (Flat) (Level)			
(4) Purpose of Well: <u>Domestic</u> (Domestic Irrigation Municipal, Industrial, Other)			


CODED

Information upon completion of well:

- (1) Diameter 1 1/4 inches.
- (2) Total Depth 190 feet.
- (3) Water level 12 feet below top of ground.
- (4) Cased to 178, Size 1 1/4
- (5) Screen: Size 60, Length 10
- (6) Were any formations sealed against pollution?
 yes, no.

If YES depth of formation 30 feet
Why sand

Drillers Remarks:

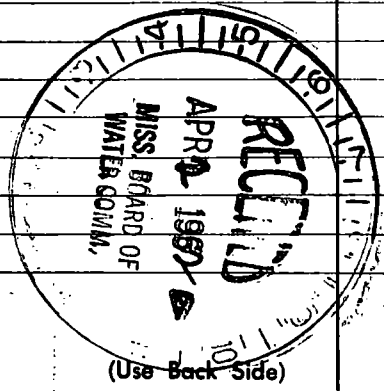

Well No.

0000

Handwritten notes and scribbles at the top of the page, including some illegible characters and lines.

Handwritten notes and scribbles in the middle section of the page, separated by a horizontal line.

Handwritten notes and scribbles in the bottom section of the page, separated by a horizontal line.