

HAR. MISSISSIPPI BOARD OF WATER COMMISSIONERS

0222

627960.9

9-7-61

WATER WELL DRILLERS LOG

**CODED**

K-300

K-317

Date: 9-7, 1961, Driller: Sutter Well Wks. County Harrison

(Name)

(1) Owner of Land: J M Alexander  
(Name)

Long Beach, Miss.  
(Address)

(2) Location: 1/4, 1/4, Sec. 13 T 8 R 12

2 miles N Long Beach  
(distance) (direction) (Nearest Town)

(3) Topography: flat  
(Hilly) (Flat) (Level)

(4) Purpose of Well: domestic  
(Domestic Irrigation  
Municipal, Industrial, Other)

Description & Color of Materials  
Sand, Clay, Red Clay, Shell, etc.

Thick-  
ness  
Feet

Depth  
Feet

<del>Clay</del> Clay	60	60
sand	20	80
Clay	310	390
sand	50	440
Clay	87	527
sand	54	581

Information upon completion of well:


- (1) Diameter 2 inches.
- (2) Total Depth 581 feet.
- (3) Water Level 10 feet above below top of ground.
- (4) Cased to all, Size 2"
- (5) Screen: Size 2", Length 16'
- (6) Were any formations sealed against pollution?  
\_\_\_\_\_ yes,  no.

If YES depth of formation \_\_\_\_\_

Why \_\_\_\_\_


Drillers Remarks: \_\_\_\_\_

**CODED**

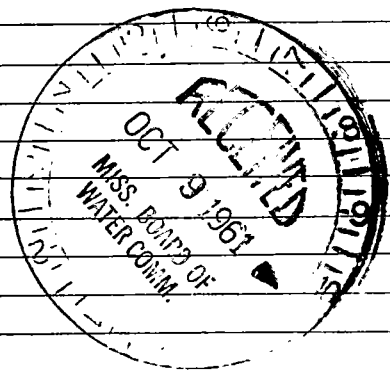

(Use Back Side)

Well No.

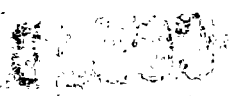

1911

1911

