

HARRISON
 0224
 1-18-71

MISSISSIPPI
 BOARD OF WATER COMMISSIONERS
 416 North State Street
 Jackson, Mississippi 39201

CODED

WATER WELL DRILLERS LOG

1/18 1971 W Pineville Well Co Harrison
 date well completed firm name county well located

LANDOWNER Fred Boatman
Pineville Rd
Long Beach, Miss.
 (mailing address)

WELL LOCATION:
 sec 9 T 8 R 12
 S W B W
 (distance) miles (direction) of (nearest town)

WELL PURPOSE:
 (home, irrigation, municipal, industrial)

WELL COMPLETION DATA:
 (1) diameter (inches) 2"
 (2) total depth (feet) 420'
 (3) static water level (feet) 6 below
 top of ground.
 (4) casing Galv pipe 4/10
 (material) (depth)
 (size) If telescope see back.
 (5) screen 10' 4/10
 (length) (depth to top)
2" All S.S.
 (size) (material)
 (6) pump N/A N/A
 (HP) (yield gpm)
N/A
 (type power)
 (7) electric log _____
 (yes or no)
 (organization running log)
 (8) how well bottom plugged Sand

description of formations encountered	from	to
top sand	0	18
Hard pipe clay	18	200
blue	200	218
good water sand	200	218
soft or med. blue clay	218	385
good cone water sand	385	420

CODED


MAR 3 - 1971

MISS. BD. OF
 WATER COMM.

DRILLERS REMARKS:

If well telescopes please sketch, and show depths.

GROUND LEVEL

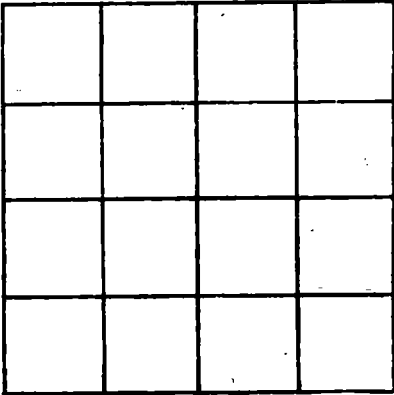

SECTION _____

Please indicate well location X.

ADDITIONAL INFORMATION

A series of 19 horizontal lines provided for entering additional information.

If more than one screen, show locations of each on sketch.