

0227  
 HARRISON Co  
 Log # 101

MISSISSIPPI  
 BOARD OF WATER COMMISSIONERS  
 416 North State Street  
 Jackson, Mississippi 39201

**CODED**

WATER WELL DRILLERS LOG

5-29 1973 date well completed  
 Switzer Well Co. firm name  
 Harrison county well located

LANDOWNER: H.E. Wilson  
 6383 Owl Roost Rd.  
 Long Beach MS 39560  
Pass Christian, Miss.  
 (mailing address)

WELL LOCATION:  
 sec 5 T 8 S R 12 W  
 2 1/2 miles N of Pass Christian  
 (distance) (direction) (nearest town)

WELL PURPOSE: Home  
 (home, irrigation, municipal, industrial)

WELL COMPLETION DATA:  
 (1) diameter (inches) 6"  
 (2) total depth (feet) 1578'  
 (3) static water level (feet) + 75 below/above top of ground.  
 (4) casing black 1578'  
42' of (material) (depth)  
 (size) If telescope see back.  
 (5) screen 60 1518'  
 (length) (depth to top)  
 (size) (material)  
 (6) pump None  
 (HP) (yield gpm)  
 (type power)  
 (7) electric log yes  
U.S. Geological Survey  
 (organization running log)  
 (8) how well bottom plugged black  
wash

description of formations encountered	from	to
clay	0	103
sand	103	108
clay	108	125
sand	125	135
clay	135	158
stn.	158	163
clay	163	192
sand	192	193
clay	193	201
stn.	201	212
sand	212	234
sand stn.	234	244
clay + shal	244	278
clay	278	347
shale + sand stn.	347	369
mixed	369	379
sand	379	390
sand good	390	413
sand	413	418
clay	418	443
sand	443	461
clay	461	491
sand	491	499
mixed	499	521
shalt + clay	521	542
clay	542	563
clay + shal	563	586
clay	586	598
sand	598	650
sand extra good	650	673
sand	673	694
sand - poor gravel	694	759
sand	759	844
shale	844	848
sand	848	870
sand + gravel	870	891
sand + clay	891	912
gravel + sand	912	978
sand	978	992
clay	992	1027
sand, fine	1027	1110


**CODED**

DRILLERS REMARKS:  
 JUN 20 1973

(over)

If well telescopes please sketch and show depths.

GROUND LEVEL

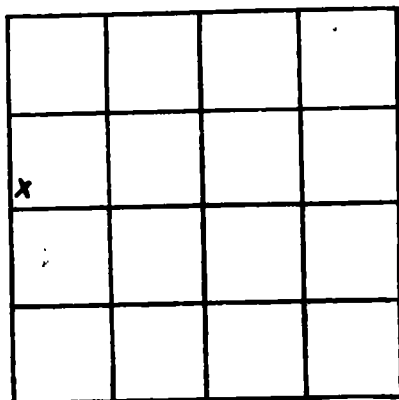

SECTION 5

Please indicate well location X.

ADDITIONAL INFORMATION

- 1110 - 1264 clay + shale
- 1264 - 1272 clay
- 1272 - 1274 sand
- 1274 - 1284 hard shale on rock
- 1284 - 1352 shale + clay
- 1352 - 1415 clay + shale
- 1415 - 1516 shale
- 1516 - 1578 sand
- 1578 - 1622 shale
- 1622 - 1647 sand
- 1647 - 1655 shale
- 1655 - 1698 clay + shale
- 1698 - 1720 sand + clay str.
- 1720 - 1786 sand - medium
- 1786 - 1797 clay

Well Set at 1578'

If more than one screen, show locations of each on sketch.