

HARRISON
 228
 2-12-71

MISSISSIPPI
 BOARD OF WATER COMMISSIONERS
 416 North State Street
 Jackson, Mississippi 39201

CODED

WATER WELL DRILLERS LOG

2/12 1971 date well completed
 McGill Well Works Harrison firm name
 county well located

LANDOWNER: Frank Moses
 4511 Finley St.
 Gulfport (mailing address)

description of formations encountered	from	to
topsoil	0	1
sand	1	30

WELL LOCATION:
 sec. 8 N R. 12 E
 Blue S W
 2 miles E of L.B.
 (distance) (direction) (nearest town)

WELL PURPOSE: Irrigation
 (home, irrigation, municipal, industrial)

- WELL COMPLETION DATA:
- (1) diameter (inches) 1 1/4"
 - (2) total depth (feet) 30'
 - (3) static water level (feet) 2 1/2' below top of ground.
 - (4) casing gal. 20' (material) (depth)
 (size) If telescope see back.
 - (5) screen 10' (length) (depth to top)
 1 1/4" (size) gal (material)
 - (6) pump 1 (HP) 11 (yield gpm)
 electric (type power)
 - (7) electric log no (yes or no)
 (organization running log)
 - (8) how well bottom plugged sand
 shank


CODED

DRILLERS REMARKS:

MAY 29 1973

If well telescopes please sketch and show depths.

GROUND LEVEL

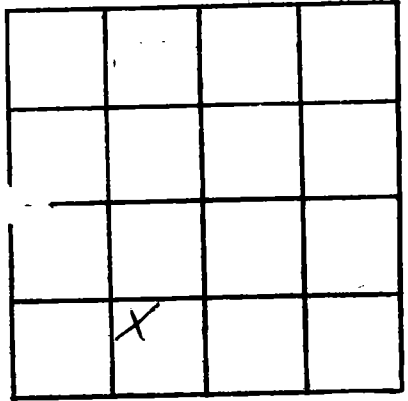

SECTION *in blue*

Please indicate well location X.

ADDITIONAL INFORMATION

Lined area for additional information.

If more than one screen, show locations of each on sketch.