

HARRISON
Ø 230.
5-21-73

MISSISSIPPI
 BOARD OF WATER COMMISSIONERS
 416 North State Street
 Jackson, Mississippi 39201

CODED

WATER WELL DRILLERS LOG

MAY 21 1973 H.A. Kadnier's Well Wks. HARRISON
 date well completed firm name county well located

LANDOWNER: Ramie Lassaba
Commission Road
Long Beach, Miss.
 (mailing address)

description of formations encountered	from	to
<u>Yellow Dirt</u>	<u>0</u>	<u>80</u>
<u>Blue Clay</u>	<u>80</u>	<u>212</u>
<u>Blue Sand</u>	<u>212</u>	<u>252</u>

WELL LOCATION:
 sec. 2 T. 8 S. R. 12 W.
2 miles North of Long Beach
 (distance) (direction) (nearest town)

WELL PURPOSE: HOME
 (home, irrigation, municipal, industrial)

- WELL COMPLETION DATA:
- (1) diameter (inches) 2 inch
 - (2) total depth (feet) 252 ft.
 - (3) static water level (feet) 12 below top of ground.
 - (4) casing Galv., 242 ft.
 (material) (depth)
2 in. if telescope see back.
 (size)
 - (5) screen 10 ft., 242 ft.
 (length) (depth to top)
2 in., S. STEEL
 (size) (material)
 - (6) pump NONE
 (HP) (yield gpm)
 (type power)
 - (7) electric log No
 (yes or no)
 (organization running log)
 - (8) how well bottom plugged Ball Check

CODED


JUN 22 1973

MISS. BOARD OF WATER COMMISSIONERS

DRILLERS REMARKS:

If well telescopes please sketch and show depths.

GROUND LEVEL

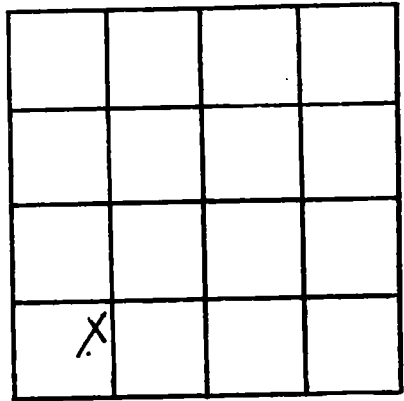

SECTION 2

Please indicate well location X.

ADDITIONAL INFORMATION

If more than one screen, show locations of each on sketch.