

Harrison
 φ 233
 8-2-73

MISSISSIPPI
 BOARD OF WATER COMMISSIONERS
 416 North State Street
 Jackson, Mississippi 39201
 WATER WELL DRILLERS LOG

SEP 17 1973
CODED
 WATER


8-2 19 73 Sutter Well Works Harrison
 date well completed firm name county well located

LANDOWNER: <u>L. A. Koennen, Jr.</u> <u>Long Beach, Miss.</u>	description of formations encountered	from	to
(mailing address)	Sand	0	36
WELL LOCATION:	Clay	36	42
sec. <u>15</u> T. <u>8</u> N. R. <u>12</u> E. <u>3</u> miles in <u>Long Beach</u> (distance) (direction) (nearest town)	Sand	42	55
WELL PURPOSE: <u>Irrigation</u> (home, irrigation, municipal, industrial)	Clay	55	414
WELL COMPLETION DATA:	Sand	414	436
(1) diameter (inches) <u>3" x 4"</u>			
(2) total depth (feet) <u>436'</u>			
(3) static water level (feet) <u>8'</u> below top of ground.			
(4) casing <u>steel</u> , <u>426'</u> (material), (depth), <u>3" & 4"</u> if telescope see back. (size)			
(5) screen <u>10'</u> , <u>426'</u> (length), (depth to top) <u>3"</u> , <u>stainless steel</u> (size), (material)			
(6) pump <u>2</u> , <u>40</u> (HP), (yield gpm) <u>elec.</u> (type power)			
(7) electric log <u>no</u> (yes or no)			
(organization running log)			
(8) how well bottom plugged <u>B.P. Valve</u>			
DRILLERS REMARKS: <u>Si</u>			

CODED

If well telescopes please sketch and show depths.

GROUND LEVEL

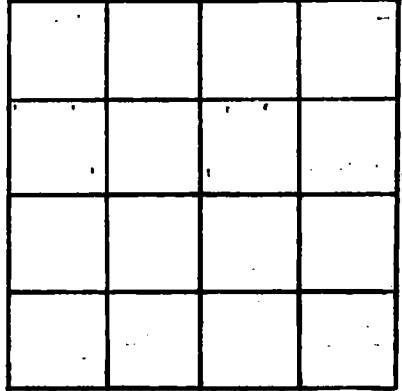

SECTION _____

Please indicate well location X.

ADDITIONAL INFORMATION

If more than one screen, show locations of each on sketch.