

Harrison
 Φ 236
 5-7-73

MISSISSIPPI
 BOARD OF WATER COMMISSIONERS
 416 North State Street
 Jackson, Mississippi 39201

CODED

WATER WELL DRILLERS LOG


May 7 1973 Sutter Well Works Harrison
 date well completed firm name county well located

LANDOWNER: H. A. Dubuissou	description of formations encountered	from	to
Box 1081	clay	0	10
Gulfport, Miss.	sand	10	45
(mailing address)	clay-sand streaks	45	382
WELL LOCATION:	sand	382	409
sec. 6 T. 8 S. R. 12 E. 1 miles NW of Ocean Springs (distance) (direction) (nearest town)			
WELL PURPOSE: home (home, irrigation, municipal, industrial)			
WELL COMPLETION DATA:			
(1) diameter (inches) 2"			
(2) total depth (feet) 409'			
(3) static water level (feet) 0' below top of ground.			
(4) casing galv. 399' (material) (depth) 2" (size) if telescope see back.			
(5) screen 10' 399' (length) (depth to top) 2" stainless steel (size) (material)			
(6) pump owner's (HP) (yield gpm) (type power)			
(7) electric log no (yes or no) (organization running log)			
(8) how well bottom plugged B.P. Value			
DRILLERS REMARKS:	SEP 5 1973 MISS. ST. OF WATER COMM		

CODED

If well telescopes please sketch and show depths.

GROUND LEVEL

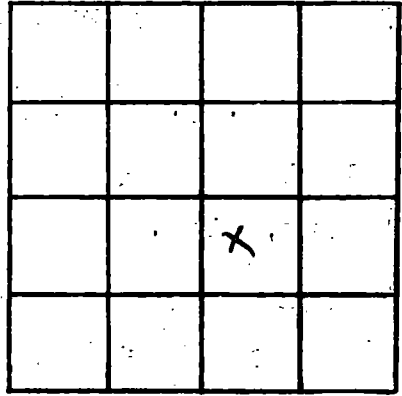

SECTION 6

Please indicate well location X.

ADDITIONAL INFORMATION

If more than one screen,
show locations of each on sketch.