

HARRISON
Φ 243
1-25-74

MISSISSIPPI
 BOARD OF WATER COMMISSIONERS
 416 North State Street
 Jackson, Mississippi 39201

WATER WELL DRILLERS LOG

Jan. 25 19 74 McGill well works Harrison
 date well completed firm name county well located

LANDOWNER: Jerry Hamilt
Rt. 1, Box 152
Long Beach, Ms.
 (mailing address)

WELL LOCATION:
 sec. 4 T. 8 N. R. 12 E.
4 miles W of Long Beach
 (distance) (direction) (nearest town)

WELL PURPOSE: home
 (home, irrigation, municipal, industrial)


- WELL COMPLETION DATA:
- (1) diameter (inches) 2"
 - (2) total depth (feet) 288'
 - (3) static water level (feet) 19' below top of ground.
 - (4) casing gal. (material) 278' (depth)
 (size) if telescope see back
 - (5) screen 10' (length) (depth to top)
2" (size) 2.5. (material)
 - (6) pump 1 (HP) 11 (yield gpm)
electric (type power)
 - (7) electric log NO (yes or no)
 - (organization running log)
 - (8) how well bottom plugged feel
what value

description of formations encountered	from	
	ft	ft
clay	0	10
course sand	10	62
Blue clay	62	138
slush	138	147
course sand	147	155
Blue clay	155	183
slush	183	238
clay	238	261
course sand	261	288
CODED		
CODED		
FEB 1974		
MISS. Bd. OF WATER COMM.		

DRILLERS REMARKS:

If well telescopes please sketch and show depths.

GROUND LEVEL

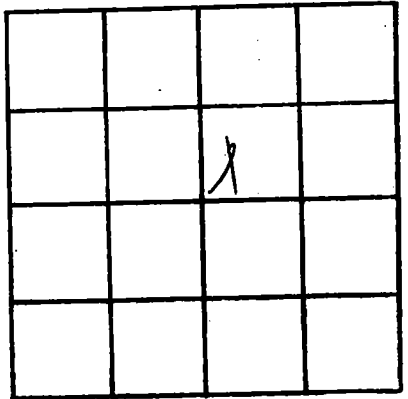

SECTION 4

Please indicate well location X.

ADDITIONAL INFORMATION

If more than one screen, show locations of each on sketch.