

HARRISON
Φ 244
5-24-73

MISSISSIPPI
 BOARD OF WATER COMMISSIONERS
 416 North State Street
 Jackson, Mississippi 39201

WATER WELL DRILLERS LOG

May 24 1973 *Mc Gill Well Works* *Harrison*
 date well completed firm name county well located

LANDOWNER: *Westly Daye*
Rt. 1 Box 284
Long Beach Ms.
 (mailing address)

description of formations encountered	from	to
<i>clay</i>	<i>0</i>	<i>15</i>
<i>fine sand</i>	<i>15</i>	<i>35</i>
<i>slush</i>	<i>35</i>	<i>50</i>
<i>course sand</i>	<i>50</i>	<i>65</i>

WELL LOCATION:
 sec. *10* T. *8* N R. *12* E
 S W
1 miles *NE* of *Long Beach*
 (distance) (direction) (nearest town)

WELL PURPOSE: *None*
 (home, irrigation, municipal, industrial)

WELL COMPLETION DATA:

(1) diameter (inches) *2"*

(2) total depth (feet) *65'*

(3) static water level (feet) *2'* below above top of ground.

(4) casing *plastic* *55'*
 (material) (depth)

— If telescope see back.
 (size)

(5) screen *10'* *10'*
 (length) (depth to top)

2" *plastic*
 (size) (material)

(6) pump *1/2* *11*
 (HP) (yield gpm)

electric
 (type power)

(7) electric log *no*
 (yes or no)

—
 (organization running log)

(8) how well bottom plugged *plug*

CODED


CODED

REGISTERED
 DRILLERS
 FEB 4 1974

DRILLERS REMARKS:

If well telescopes please sketch and show depths.

GROUND LEVEL

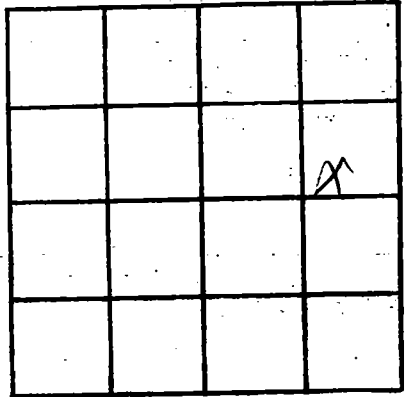

SECTION 10

Please indicate well location X.

ADDITIONAL INFORMATION

Lined area for additional information.

If more than one screen, show locations of each on sketch.