

S.W.
 HARRISON
 245
 3-31-73

MISSISSIPPI
 BOARD OF WATER COMMISSIONERS
 416 North State Street
 Jackson, Mississippi 39201

WATER WELL DRILLERS LOG

3-31-73, date well completed MC. Hie Well Works, firm name Harrison, county well located

LANDOWNER: Mc. Kieren
130 Vance Place

description of formations encountered	from	to
<u>sand</u>	<u>0</u>	<u>30</u>

(mailing address)

WELL LOCATION:
 sec 16 T 8 N R 12 E
3 miles West Shelby
 (distance) (direction) (nearest town)

WELL PURPOSE: irrigation
 (home, irrigation, municipal, industrial)

- WELL COMPLETION DATA:
- (1) diameter (inches) 2 1/2
 - (2) total depth (feet) 301
 - (3) static water level (feet) 2' below above top of ground
 - (4) casing plastic 20'
 (material) (depth)
 - _____ If telescope see back.
 (size)
 - (5) screen 10' _____
 (length) (depth to top)
 - 2" plastic
 (size) (material)
 - (6) pump 1/2 16
 (HP) (yield gpm)
 - electric
 (type power)
 - (7) electric log no
 (yes or no)

CODED


(organization running log)
 (8) how well bottom plugged sand
shark

DRILLERS REMARKS:

MAY 2 1974

If well telescopes please sketch and show depths.

GROUND LEVEL

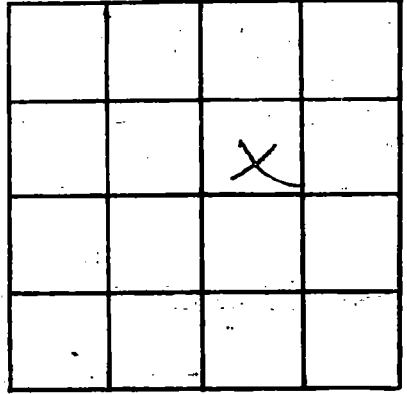

SECTION 46

Please indicate well location X.

ADDITIONAL INFORMATION

If more than one screen, show locations of each on sketch.