

HARRISON

~~3~~ 246

3-19-73

MISSISSIPPI
BOARD OF WATER COMMISSIONERS
416 North State Street
Jackson, Mississippi 39201

WATER WELL DRILLERS LOG

3/19 1973
date well completed

McGill Well Works
firm name

Harrison
county well located

LANDOWNER: Mrs. Sutton

103 St. Augustine Dr.
Long Beach Miss.
(mailing address)

description of formations encountered

from to

Sand

0 3

WELL LOCATION:

sec. 17 T-8 N R-12 E
S W
3 miles W of Long Beach
(distance) (direction) (nearest town)


WELL PURPOSE: ~~Domestic~~
(home, irrigation, municipal, industrial)

WELL COMPLETION DATA:

- (1) diameter (inches) 2"
- (2) total depth (feet) 30'
- (3) static water level (feet) 4' below top of ground
- (4) casing ~~plastic~~ 20'
(material) (depth)
- (size) If telescope see back.
- (5) screen 10' (length) (depth to top)
- 2" (size) plastic (material)
- (6) pump 1/2 (HP) 8 (yield gpm)
- electric (type power)
- (7) electric log no (yes or no)
- (organization running log)
- (8) how well bottom plugged sand
shank


CODED

DRILLERS REMARKS:

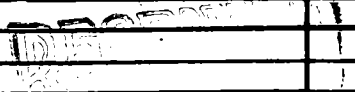

If well telescopes please sketch and show depths.

GROUND LEVEL

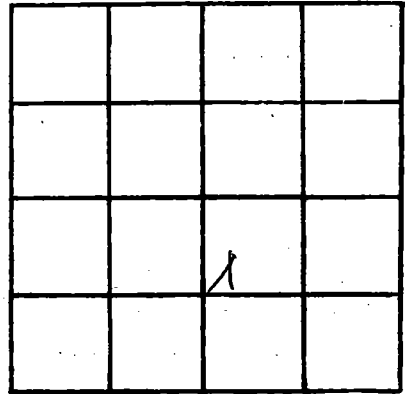

SECTION 17

Please indicate well location X.

ADDITIONAL INFORMATION

If more than one screen,
show locations of each on sketch.