

HARRISON
 249
 8-3-74

MISSISSIPPI
 BOARD OF WATER COMMISSIONERS
 416 North State Street
 Jackson, Mississippi 39201

CODED

WATER WELL DRILLERS LOG

8-3-74 19 R. J. Moore HARRISON
 date well completed firm name county well located

LANDOWNER: J. E. Brewer
Pineville RD 518
Long Beach MISS
 (mailing address)

description of formations encountered	from	to
<u>TOP Sand</u>	<u>10</u>	<u>30</u>
<u>Blue clay</u>	<u>30</u>	<u>475</u>
<u>Grassy Sand</u>	<u>475</u>	<u>506</u>

WELL LOCATION:
 sec 11 T 8 N R 12 E
1 miles N of Long Beach
 (distance) (direction) (nearest town)

WELL PURPOSE:
 (home, irrigation, municipal, industrial)

WELL COMPLETION DATA:

(1) diameter (inches) 2"

(2) total depth (feet) 506

(3) static water level (feet) 16' ^{below} top of ground.

(4) casing 94W 496'
 (material) (depth)
 (size) if telescope see back.


(5) screen 10' 496'
 (length) (depth to top)
2" SS
 (size) (material)

(6) pump 1 12
 (HP) (yield gpm)
E
 (type power)

(7) electric log _____
 (yes or no)
 (organization running log)

(8) how well bottom plugged
Butt

CODED

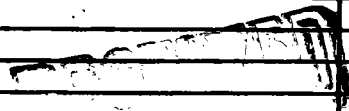


AUG 16 1974

MISS. BD. OF WATER COMMISSIONERS

DRILLERS REMARKS:

If well telescopes please sketch and show depths.

GROUND LEVEL

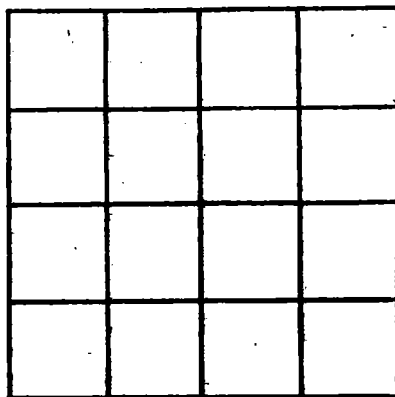

SECTION _____

Please indicate well location X.

ADDITIONAL INFORMATION

If more than one screen, show locations of each on sketch.