

**Harrison**  
**Ø 252**  
**11-21-73**

MISSISSIPPI  
 BOARD OF WATER COMMISSIONERS  
 416 North State Street  
 Jackson, Mississippi 39201

**CODED**

**WATER WELL DRILLERS LOG**


November 21 1973 A.A. Ladwiler Well Works HARRISON  
 date well completed firm name county well located

LANDOWNER: <u>W.D. Williamson</u>	description of formations encountered	from	to
<u>Pineville Road</u> <u>Long Beach Miss.</u> (mailing address)			
<b>WELL LOCATION:</b> sec. <u>3</u> T. <u>8</u> R. <u>12</u> <u>2</u> miles <u>SE</u> of <u>Cuevas</u> (distance) (direction) (nearest town)	<u>yellow clay</u> <u>yellow sand</u> <u>yellow clay</u> <u>blue clay</u> <u>blue sand</u>	<u>0</u> <u>30</u> <u>70</u> <u>100</u> <u>170</u>	<u>30</u> <u>70</u> <u>100</u> <u>170</u> <u>195</u>
<b>WELL PURPOSE:</b> <u>HOME</u> (home, irrigation, municipal, industrial)			
<b>WELL COMPLETION DATA:</b> (1) diameter (inches) <u>2</u> (2) total depth (feet) <u>195</u> (3) static water level (feet) <u>15</u> below above top of ground. (4) casing <u>Galv.</u> <u>185 ft.</u> (material) (depth) <u>2 inch</u> if telescope see back. (size) (5) screen <u>10 ft.</u> <u>18.5 ft.</u> (length) (depth to top) <u>2 inch</u> <u>S. STEEL</u> (size) (material) (6) pump <u>1</u> <u>8</u> (HP) (yield gpm) <u>Electric</u> (type power) (7) electric log <u>NO</u> (yes or no) (organization running log) (8) how well bottom plugged <u>Ball Check</u>			
<b>DRILLERS REMARKS:</b>			

RECEIVED  
 NOV - 4 1974

If well telescopes please sketch and show depths.

GROUND LEVEL

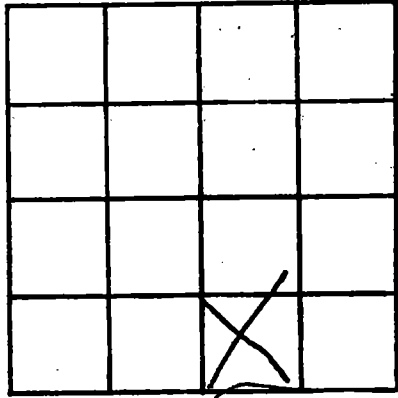

SECTION

3

Please indicate well location X.

ADDITIONAL INFORMATION

If more than one screen, show locations of each on sketch.