

Harrison
Ø 253
8-19-74

MISSISSIPPI
 BOARD OF WATER COMMISSIONERS
 416 North State Street
 Jackson, Mississippi 39201

CODED

WATER WELL DRILLERS LOG

Aug. 14
 date well completed

1974 Ladnier's Well Works
 firm name

Harrison
 county well located


| LANDOWNER: <u>Gerald Walker</u> <u>Lovers Lane</u> <u>Long Beach, MS</u> (mailing address) | description of formations encountered | from | to |
|--|---------------------------------------|------------|------------|
| | <u>yellow clay</u> | <u>0</u> | <u>90</u> |
| | <u>yellow sand</u> | <u>90</u> | <u>120</u> |
| | <u>yellow clay</u> | <u>120</u> | <u>140</u> |
| | <u>blue clay</u> | <u>140</u> | <u>350</u> |
| | <u>blue sand</u> | <u>350</u> | <u>630</u> |
| WELL LOCATION: sec. <u>2</u> T. <u>8</u> S. R. <u>12</u> W. <u>3</u> miles <u>NW</u> of <u>Long Beach</u> (distance) (direction) (nearest town) | | | |
| WELL PURPOSE: <u>home</u> (home, irrigation, municipal, industrial) | | | |
| WELL COMPLETION DATA: (1) diameter (inches) <u>2 in.</u> (2) total depth (feet) <u>630 ft</u> (3) static water level (feet) <u>10</u> below top of ground. (4) casing <u>galv.</u> <u>620</u> (material) (depth) <u>2 in.</u> If telescope see back. (size) (5) screen <u>10 ft.</u> <u>620 ft</u> (length) (depth to top) <u>2 in.</u> <u>st. steel</u> (size) (material) (6) pump <u>1</u> <u>10</u> (HP) (yield gpm) <u>elec.</u> (type power) (7) electric log <u>NO</u> (yes or no) (organization running log) (8) how well bottom plugged <u>ball check</u> | | | |
| DRILLERS REMARKS: | | | |

RECORDED
 NOV - 4 1974

MISS. BD. OF WATER COMMISSIONERS

If well telescopes please sketch and show depths.

GROUND LEVEL

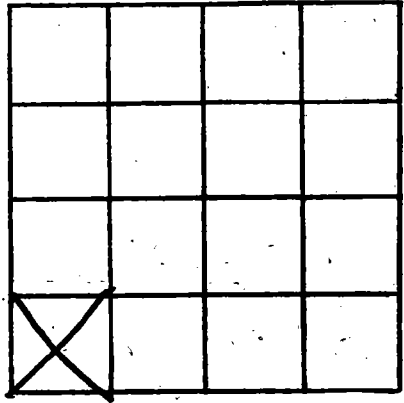

SECTION 2

Please indicate well location X.

ADDITIONAL INFORMATION

If more than one screen, show locations of each on sketch.