

Harrison
Ø 254
8-22-73

MISSISSIPPI
 BOARD OF WATER COMMISSIONERS
 416 North State Street
 Jackson, Mississippi 39201

CODED


WATER WELL DRILLERS LOG

August 22 1973 H.A. Laddier's Well Works HARRISON
 date well completed firm name county well located

LANDOWNER: <u>John Palmer</u>	description of formations encountered	from	to
<u>SEA 1 AVENUE</u> <u>LONG BEACH, MISS.</u> (mailing address)	<u>yellow clay</u>	<u>0</u>	<u>30</u>
	<u>yellow sand</u>	<u>30</u>	<u>80</u>
	<u>yellow clay</u>	<u>80</u>	<u>150</u>
	<u>blue clay</u>	<u>150</u>	<u>310</u>
	<u>blue sand</u>	<u>310</u>	<u>370</u>
WELL LOCATION: sec. <u>Q T 8</u> R. <u>12</u> <u>1</u> miles <u>NW</u> of <u>Long Beach</u> (distance) (direction) (nearest town)			
WELL PURPOSE: <u>HOME</u> (home, irrigation, municipal, industrial)			
WELL COMPLETION DATA:			
(1) diameter (inches) <u>2 inch</u>			
(2) total depth (feet) <u>370 ft.</u>			
(3) static water level (feet) <u>12</u> below above top of ground.			
(4) casing <u>Galv.</u> <u>360 ft.</u> (material) (depth)			
<u>2 inch</u> if telescope see back. (size)			
(5) screen <u>10 ft.</u> <u>360 ft.</u> (length) (depth to top)			
<u>2 inch, STAINLESS STEEL</u> (size) (material)			
(6) pump <u>1</u> <u>10</u> (HP) (yield gpm)			
<u>Electric</u> (type power)			
(7) electric log <u>NO</u> (yes or no)			
(organization running log)			
(8) how well bottom plugged <u>Ball Check</u>			
DRILLERS REMARKS:			
<div style="text-align: right; border: 1px solid black; padding: 5px; width: fit-content; margin: 0 auto;"> RECEIVED NOV - 4 1974 </div>			
<div style="text-align: right; margin: 0 auto;"> ER COMM </div>			

If well telescopes please sketch and show depths.

GROUND LEVEL

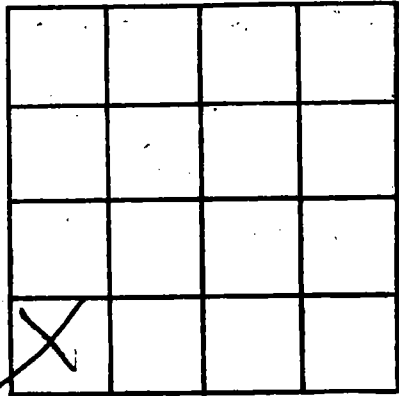

SECTION 2

Please indicate well location X.

ADDITIONAL INFORMATION

If more than one screen,
show locations of each on sketch.