

P

Harrison  
Ø 257  
7-26-74

MISSISSIPPI  
 BOARD OF WATER COMMISSIONERS  
 416 North State Street  
 Jackson, Mississippi 39201

CODED

WATER WELL DRILLERS LOG

7-26-74 19 Sutter Well Works Harrison  
 date well completed firm name county well located

LANDOWNER: R. Caberrombie  
1014 Center  
Arabi, Louisiana  
 (mailing address)

WELL LOCATION:  
 sec. 18 T. 8 N. R. 12 E  
 S W  
1 miles S of Cuevas  
 (distance) (direction) (nearest town)

description of formations encountered	from	to
Yellow clay	0	15
Blue clay	15	168
Fine sand	168	175
Clay-sand streaks	175	236
Sand	236	247

WELL PURPOSE: home  
 (home, irrigation, municipal, industrial)


- WELL COMPLETION DATA:
- (1) diameter (inches) 2"
  - (2) total depth (feet) 247'
  - (3) static water level (feet) 0 below above top of ground.
  - (4) casing galv., 242'  
 (material) (depth)  
2" if telescope see back.  
 (size)
  - (5) screen 5', 242'  
 (length) (depth to top)  
2", stainless steel  
 (size) (material)
  - (6) pump Owner's  
 (HP) (yield gpm)  
 (type power)
  - (7) electric log no  
 (yes or no)  
 (organization running log)
  - (8) how well bottom plugged B.P. Valve

DRILLERS REMARKS:

RECORDED  
 INDEXED  
 OCT 25 1974

If well telescopes please sketch and show depths.

GROUND LEVEL

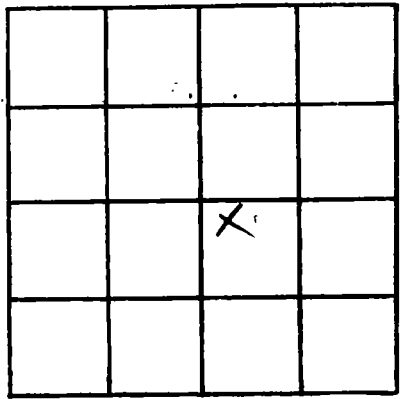

SECTION \_\_\_\_\_

Please indicate well location X.

ADDITIONAL INFORMATION

Lined area for additional information.

If more than one screen, show locations of each on sketch.