

Harrison  
 Q 263  
 3-12-75

MISSISSIPPI  
 BOARD OF WATER COMMISSIONERS  
 416 North State Street  
 Jackson, Mississippi 39201

CODED

WATER WELL DRILLERS LOG

3/12 date well completed 1975 McGill Well Works (Harrison) firm name Harrison county well located

LANDOWNER: Betty Wilkes Vogt  
 Rt. 1 Box 138  
 Long Beach, Miss.  
 (mailing address)  
 WELL LOCATION: 135  
 sec. 19 T. 8 N. R. 2 E  
 6 miles W of Long Beach  
 (distance) (direction) (nearest town)

description of formations encountered	from	to
clay	0	32
coarse sand	32	112
slush	112	167
blue clay	167	209
slush	209	247
fine sand	247	291
slush	291	338
fine sand	338	371
slush	371	412
blue clay	412	442
coarse silt	442	462

WELL PURPOSE: home  
 (home, irrigation, municipal, industrial)


WELL COMPLETION DATA:  
 (1) diameter (inches) 2"  
 (2) total depth (feet) 462  
 (3) static water level (feet) 2' below top of ground.  
 (4) casing plastic 452' (material) (depth)  
 2" (size) if telescope see back.  
 (5) screen 10' (length) (depth to top)  
 2" (size) S.S. (material)  
 (6) pump 1 (HP) 8 (yield gpm)  
 Electric (type power)  
 (7) electric log no (yes or no)  
 (organization running log)  
 (8) how well bottom plugged Seal Shank

RECEIVED  
 APR 14 1975

DRILLERS REMARKS:

If well telescopes please sketch and show depths.

GROUND LEVEL

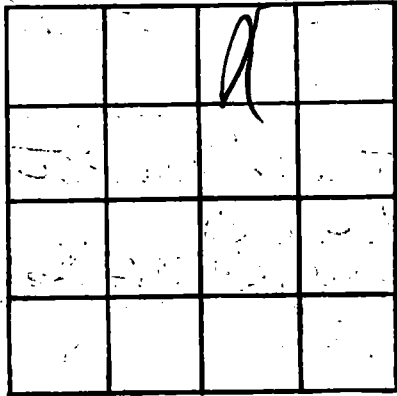

SECTION 17

Please indicate well location X.

ADDITIONAL INFORMATION

If more than one screen, show locations of each on sketch.