

Harrison
 264
 1-75

MISSISSIPPI
 BOARD OF WATER COMMISSIONERS
 416 North State Street
 Jackson, Mississippi 39201

CODED

WATER WELL DRILLERS LOG

Jan. 1975 date well completed
 McNeil well works firm name
 Harrison county well located

LANDOWNER: Dr. Edward
 Hamard.
 Bayne Package
 Ass Christian miss.
 (mailing address)

WELL LOCATION:
 sec. 18 T 8 N R 12 E 13S
 5 miles S.W. of Cuscuta
 (distance) (direction) (nearest town)

WELL PURPOSE:
 (home, irrigation, municipal, industrial)

WELL COMPLETION DATA:

(1) diameter (inches) 2"
 (2) total depth (feet) 795'
 (3) static water level (feet) 1" below top of ground.
 (4) casing gal. 275.
 (material) (depth)
 (size) If telescope see back.
 (5) screen 20'
 (length) (depth to top)
 2" (size) 25.
 (material)
 (6) pump 1/2 (HP) 10 (yield gpm)
 Electric (type power)
 (7) electric log no (yes or no)
 (organization running log)

description of formations encountered	depth	
	from	to
Sand	0	42
Mud	42	63
Sand	63	84
mud	84	105
mud	105	189
sand	189	210
mud	210	273
sand	273	294
mud	294	357
mud	357	378
mud	378	441
slush	441	483
mud	483	504
slush	504	525
mud	525	546
slush	546	567
sand	567	630
mud	630	693
slush	693	735
sand	735	795


(8) how well bottom plugged Sand
 Spark

DRILLERS REMARKS:

RECORDED
 JUL 14 1975

If well telescopes please sketch and show depths.

GROUND LEVEL

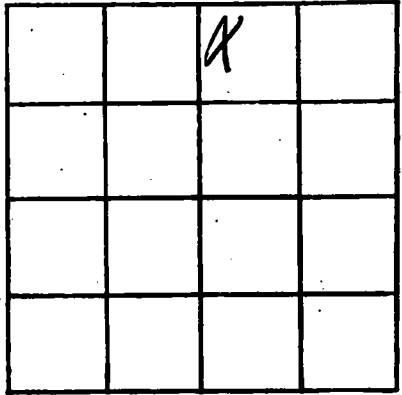

SECTION 18

Please indicate well location X.

ADDITIONAL INFORMATION

If more than one screen, show locations of each on sketch.