

Harrison
 # 265
 6-20-75

MISSISSIPPI
 BOARD OF WATER COMMISSIONERS
 416 North State Street
 Jackson, Mississippi 39201
 WATER WELL DRILLERS LOG

CODED

June 20 19 75 Sutter Well Works Harrison
 date well completed firm name county well located

LANDOWNER: M.H. Payment
 Box 495
 Gulfport, Miss.
 (mailing address)

WELL LOCATION:
 sec. 7 T 8 R 12 S W 135
 1 miles West of Crenshaw
 (distance) (direction) (nearest town)

WELL PURPOSE: Home
 (home, irrigation, municipal, industrial)

WELL COMPLETION DATA:

- (1) diameter (inches) 4" x 3"
- (2) total depth (feet) 619'
- (3) static water level (feet) 5' ~~above~~ above top of ground 63' galv.
- (4) casing bal. blk. 609'
 (material) (depth)
 3" If telescope see back.
 (size)
- (5) screen 10' 609'
 (length) (depth to top)
 4" stainless steel
 (size) (material)
- (6) pump 1/2 18
 (HP) (yield gpm)
 elec.
 (type power)
- (7) electric log no
 (yes or no)
 (organization running log)
- (8) how well bottom plugged b.p. valve

description of formations encountered

from to

| | | |
|---------------|-----|-----|
| Clay and sand | 0 | 10 |
| Sand | 10 | 72 |
| Clay | 72 | 151 |
| Sand | 151 | 198 |
| Clay | 198 | 365 |
| Sand | 365 | 421 |
| Clay | 421 | 563 |
| Sand | 563 | 571 |
| Clay | 571 | 580 |
| Sand | 580 | 619 |

CODED


RECEIVED
 SEP 19 1975

DRILLERS REMARKS:

MISS. BD. OF WATER COMM

If well telescopes please sketch and show depths.

GROUND LEVEL

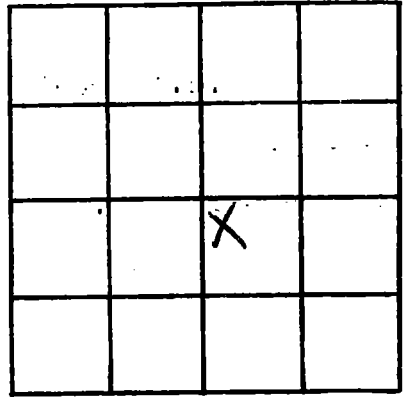

SECTION _____

Please indicate well location X.

ADDITIONAL INFORMATION

If more than one screen, show locations of each on sketch.