

MISSISSIPPI DEPARTMENT OF NATURAL RESOURCES

Bureau of Land and Water Resources

Southport Mall

P.O. Box 10631

Jackson, Mississippi 39209

WATER WELL DRILLERS LOG

COASTAL DRILLING & SERVICE CO.

CODED

HARRISON  
 # 271  
 5-29-79

1979  
 date well completed

ROUTE 1 BOX 618

Harrison  
 county well located

BILOXI, MISS. 39532

LANDOWNER:

description of formations encountered

from to

John Starbuck  
 Mergersville  
 post Christian, Min  
 (mailing address)

Top Soil	5	3
Red Clay	3	15
Coarse white sand	15	40
Sandy Sand	40	160
Soft Blue Clay	160	320
fine Water Sand	320	350
Hard Blue Clay	350	440
fine water sand	440	460
loam	460	465
hard Blue Clay	465	550
fine water sand	550	600
Coarse water sand	600	630

WELL LOCATION:

7 1/2 S R 12 E  
 sec T 2 N S R 12 E W  
 1/2 miles South pienville  
 (distance) (direction) (nearest town)

WELL PURPOSE:

(home, irrigation, municipal, industrial)

WELL COMPLETION DATA:

- (1) diameter (inches) 4 1/2"
- (2) total depth (feet) 630'
- (3) static water level (feet) 40 below above top of ground.
- (4) casing 4 1/2" (material) 615' (depth)
- (5) screen 15' (length) 615' (depth to top)
- (6) pump 2" (size) 1/2 (HP) 28 (yield gpm)
- (7) electric log (type power) No (yes or no)

(organization running log)

(8) how well bottom plugged  
 2" lead wire valve

DRILLERS REMARKS: 19-B

DEPT. OF NATURAL RESOURCES  
 BUREAU OF LAND & WATER RESOURCES

OCT 31 1980

RECEIVED

If well telescopes please sketch and show depths.

GROUND LEVEL

160' 4" PVC Casing




455' 2" PVC Casing

15' 2" PVC Screen

2" head work Valve  
19-13

If more than one screen,  
show locations of each on sketch.

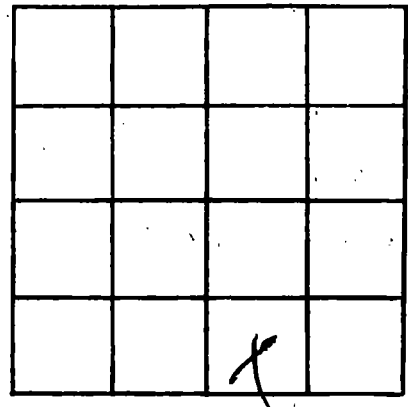

SECTION \_\_\_\_\_

Please indicate well location X.

ADDITIONAL INFORMATION

Multiple horizontal lines provided for additional information.