

Harrison  
 0272  
 5-4-81

MISSISSIPPI  
 BOARD OF WATER COMMISSIONERS  
 416 North State Street  
 Jackson, Mississippi 39201

**CODED**

WATER WELL DRILLERS LOG

5-4-81 date well completed 19 BRADEN PUMP AND WELL SERVICE HARRISON empty well located

LANDOWNER:	description of formations encountered	from	to
Annie J. COURSON Rt. 1, Box 219-F	SAND	70	70
Long Beach, MS (mailing address)	CLAY	70	90
WELL LOCATION:	SAND	90	130
sec. 11 T. 8 N. R. 12 E	CLAY	130	150
5 W	SAND	150	175
miles 17 of Long Beach	CLAY	175	225
(distance) (direction) (nearest town)	SAND	225	235
WELL PURPOSE: home	CLAY	235	240
(home, irrigation, municipal, industrial)	SAND	240	260
WELL COMPLETION DATA:	CLAY	260	280
(1) diameter (inches) 4 1/2	SAND & CLAY	280	300
(2) total depth (feet) 600	CLAY	300	460
(3) static water level (feet) 122 below top of ground.	SAND	460	480
(4) casing PVC, total!	CLAY	480	550
(material) (depth)	SAND	550	600
4 1/2 (size) If telescope see back.			
(5) screen 10 (length), 590 (depth to top)			
2" (size), PVC underbar (material)			
(6) pump 1 (HP), 20 (yield gpm)			
230 (type power)			
(7) electric log no (yes or no)			
(organization running log)			
(8) how well bottom plugged 2" sand shark			
DRILLERS REMARKS: no tail pipe			



If well telescopes please sketch and show depths.

GROUND LEVEL

4" sch 40  
PVC

4" sch 40  
Dushing

2" sch 40  
PVC


2" 10' PVC  
under bar

2" SAND SHARK

140'

590'

600'

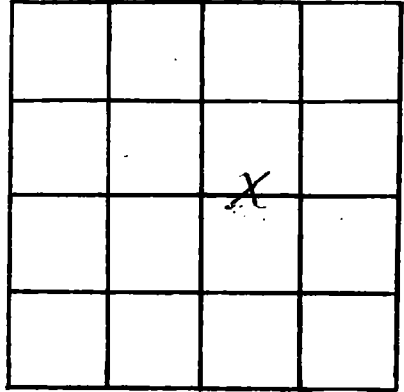

SECTION 11

Please indicate well location X.

ADDITIONAL INFORMATION

If more than one screen,  
show locations of each on sketch.