

MISSISSIPPI DEPARTMENT OF NATURAL RESOURCES

Bureau of Land and Water Resources

Southport Mall

P.O. Box 10631

Jackson, Mississippi 39209

WATER WELL DRILLERS LOG

CODED

0274
HARRISON
11-5-83

11/5/83
date well completed

Lipman Well Co.
firm name

Harrison
county well located

LANDOWNER: E.L. Moulder
Rt. 3, Bay 77C
Pass Christian 39571
(mailing address)

description of formations encountered	from	to
sand and gravel	0	120
sea shells	120	280
Blue Gumbo	280	360
fine sand clay and a log	360	480
Blue Gumbo	480	505
Good sand	505	576

WELL LOCATION:
sec. 12 T 8 N R 12 E
5 miles S W of Pass Christian
(distance) (direction) (nearest town)

WELL PURPOSE: drinking
(home, irrigation, municipal, industrial)

- WELL COMPLETION DATA:
- (1) diameter (inches) 2"
 - (2) total depth (feet) 576'
 - (3) static water level (feet) 2' below top of ground. above
 - (4) casing PVC, 506'
(material) (depth)
2"
(size) if telescope see back.
 - (5) screen 10', 506'
(length) (depth to top)
2", PVC
(size) (material)
 - (6) pump 1/2, 15
(HP) (yield gpm)
electric
(type power)
 - (7) electric log No
(yes or no)
No
(organization running log)
 - (8) how well bottom plugged sand shark


DRILLERS REMARKS:

DEPT. OF NATURAL RESOURCES
BUREAU OF LAND & WATER RESOURCES

RECEIVED
APR 26 1984

If well telescopes please sketch and show depths.

GROUND LEVEL

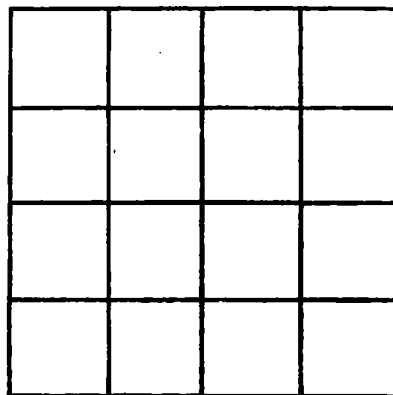

SECTION _____

Please indicate well location X.

ADDITIONAL INFORMATION

If more than one screen, show locations of each on sketch.