

MISSISSIPPI DEPARTMENT OF NATURAL RESOURCES

Bureau of Land and Water Resources

Southport Mall

P.O. Box 10631

Jackson, Mississippi 39209

WATER WELL DRILLERS LOG

CODED

HARRISON
 2, 1, 1

8-13-84

19

firm name

Harrison
 county well located

LANDOWNER: W.A. Hazen

Allen Road

Long Beach, Mo.
 (mailing address)

WELL LOCATION:

sec. 9 T. 8 N. R. 12 E. S. W
2 miles N of L.B.
 (distance) (direction) (nearest town)

WELL PURPOSE:

(home, irrigation, municipal, industrial)

WELL COMPLETION DATA:

- (1) diameter (inches) 2"
- (2) total depth (feet) 720'
- (3) static water level (feet) below top of ground.
- (4) casing sch 40 (material) 110' (depth) 110' (depth)
 (size) if telescope see back.
- (5) screen 10' (length) 710' (depth to top)
2" sch 80 slot (size) (material)
- (6) pump 1 (HP) 10 (yield gpm)
elec (type power)
- (7) electric log _____ (yes or no)
 (organization running log)
- (8) how well bottom plugged shark

description of formations encountered

from

to

Sand	0	30
sand & mud	30	40
mud	40	140
sandy mud	140	200
sand	200	230
mud	230	310
mud & sand	240	360
sand	260	280
sand & mud	350	300
mud	310	320
mud & sand	340	360
mud	360	380
mud & sand	380	460
mud	460	490
sand	470	440
mud	440	460
sand	460	490
sandy mud	480	500
mud	500	560
mud	560	580
sand	580	600
silt & mud	600	680
sand	680	720

CODED

DEPT. OF NATURAL RESOURCES
 BUREAU OF LAND & WATER RESOURCES


AUG 16 1984

RECEIVED

DRILLERS REMARKS: _____

If well telescopes please sketch and show depths.

GROUND LEVEL

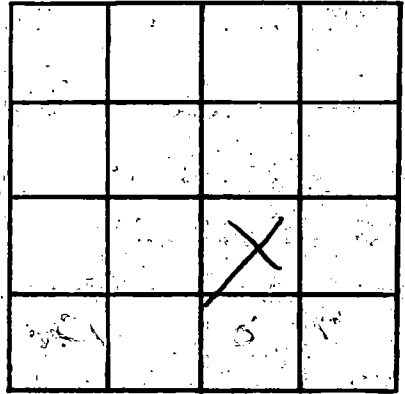

SECTION _____

Please indicate well location X.

ADDITIONAL INFORMATION

If more than one screen, show locations of each on sketch.