

MISSISSIPPI DEPARTMENT OF NATURAL RESOURCES

Bureau of Land and Water Resources

Southport Mall

P.O. Box 10631

CODED

Jackson, Mississippi 39209

WATER WELL DRILLERS LOG

HARRISON

Q 277

4/30/84

4/30/84

date well completed

firm name

county well located

Lyman Well Co.

Harrison

LANDOWNER:

Javis Const.

description of formations encountered

from

to

Arcadia Place #5, Rt 3

Pan Christian 39571

(mailing address)

TOP Sand

0 40

Green Gumbo

40 180

fine sand & clay

180 256

Blue clay

256 440

fine sand streaked

440 500

with clay

Blue clay

500 580

Big sand

580 625

WELL LOCATION:

sec 17 T 8 N R 12 E  
 4 miles n/w of Fox Beach  
 (distance) (direction) (nearest town)

WELL PURPOSE:

(home, irrigation, municipal, industrial)

Home

WELL COMPLETION DATA:

- (1) diameter (inches) 2"
- (2) total depth (feet) 625'
- (3) static water level (feet) 20' <sup>below</sup> <sub>above</sub> top of ground.
- (4) casing PVC 615'  
 (material) (depth)
- 2"  
 (size) if telescope see back.
- (5) screen 10' 615'  
 (length) (depth to top)
- 2" PVC  
 (size) (material)
- (6) pump 1 15  
 (HP) (yield gpm)
- electric  
 (type power)
- (7) electric log No  
 (yes or no)
- No  
 (organization running log)
- (8) how well bottom plugged sand  
shark

CODED

DEPT. OF NATURAL RESOURCES  
 BUREAU OF LAND & WATER RESOURCES


SEP - 5 1984

RECEIVED

DRILLERS REMARKS:

If well telescopes please sketch and show depths.

GROUND LEVEL

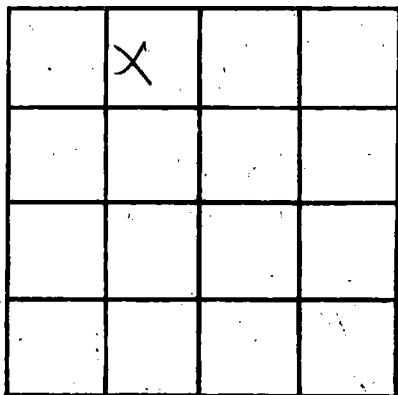

SECTION 17

Please indicate well location X.

ADDITIONAL INFORMATION

If more than one screen, show locations of each on sketch.