

MISSISSIPPI DEPARTMENT OF NATURAL RESOURCES

Bureau of Land and Water Resources

Southport Mall

P.O. Box 10631

CODED

Jackson, Mississippi 39209

WATER WELL DRILLERS LOG

Harrison
 290
 1-31-85

1-31 1985
 date well completed

Mc Well Works
 firm name

Harrison
 county well located

LANDOWNER: David A. Rosa

description of formations encountered

from

to

P.O. Box 612
 Long Beach, Ms 39560
 (mailing address)

Sand	CODED	0	20
Sand		20	40
Sand / Mud		40	60
Mud		60	80
Sand / mud		80	100
Mud		100	120
Mud		120	140
Mud		140	160
Mud		160	180
Mud		180	200
Mud		200	220
Mud / Sand		220	240
Sand / Mud		240	260
Mud		260	280
Mud		280	300
Mud		300	320
Mud		320	340
Mud / Sand		340	360
Sand		360	380
Sand		380	400

WELL LOCATION:

sec. 4 T. 8 N. R. 12 E.
 6 miles N of Pass Christ.
 (distance) (direction) (nearest town)

WELL PURPOSE:

(home, irrigation, municipal, industrial)

WELL COMPLETION DATA:

- (1) diameter (inches) 2"
- (2) total depth (feet) 400'
- (3) static water level (feet) 30' below top of ground
- (4) casing PVC Sch 40, 390', (material) (depth) (size) if telescope see back.
- (5) screen 10' (length), 390' (depth to top) 2" sch 80, 6 slot (size) (material)
- (6) pump 1 (HP), 10 (yield gpm) Elec. (type power)
- (7) electric log (yes or no) (organization running log)
- (8) how well bottom plugged SEAL

RECEIVED


MAY 31 1985

Department of Natural Resources
 Bureau of Land & Water Resources

DRILLERS REMARKS:

If well telescopes please sketch and show depths.

GROUND LEVEL

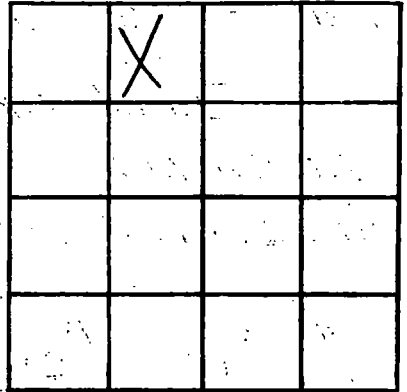

SECTION _____

Please indicate well location X.

ADDITIONAL INFORMATION

Lined area for additional information.

If more than one screen, show locations of each on sketch.