

MISSISSIPPI DEPARTMENT OF NATURAL RESOURCES

Bureau of Land and Water Resources

Southport Mall

P.O. Box 10631

Jackson, Mississippi 39209

WATER WELL DRILLERS LOG

CODED

Harrison
 0291
 2-19-85

2-19

1985

McStell Well Works

firm name

Harrison

county well located

LANDOWNER: Charles McFarlane

159 Woodland Way
 Pass Christian, Ms.
 (mailing address)

WELL LOCATION:

sec. 2 T 8 N R 12 E
 1.5 miles N of Pass Christ
 (distance) (direction) (nearest town)

WELL PURPOSE:

(home, irrigation, municipal, industrial)

WELL COMPLETION DATA:

- (1) diameter (inches) 2"
- (2) total depth (feet) 580'
- (3) static water level (feet) 70 below top of ground.
- (4) casing Pvc Sch. 40, 570' (material) (depth)
 (size) if telescope see back.
- (5) screen 10', 570' (length) (depth to top)
2", Sch. 80 6 slot (size) (material)
- (6) pump 1, 7 (HP) (yield gpm)
Elee (type power)
- (7) electric log _____
 (yes or no)
 _____ (organization running log)

(8) how well bottom plugged SAND SHARK

description of formations encountered	from	to
Mud/Sand	0	20
Sand	20	40
Sand	40	60
Sand/Mud	60	80
Mud	80	100
Mud	100	120
CODED	120	140
Mud/Sand	140	160
Mud	160	180
Mud	180	200
Mud/Sand	200	220
Sand/Mud	220	240
Sand/Mud	240	260
Sand/Mud	260	280
Mud	280	300
Mud	300	320
Mud	320	340
Mud	340	360
Mud	360	380
Mud	380	400
Mud	400	420
Mud	420	440
Mud/Sand	440	460
Mud	460	480
Mud	480	500
Mud	500	520
Sand	520	540
Sand/Gravel	540	560
Sand/Gravel	560	580


RECEIVED
 MAY 31 1985

DRILLERS REMARKS:

Department of Natural Resources
 Bureau of Land & Water Resources

If well telescopes please sketch and show depths.

GROUND LEVEL

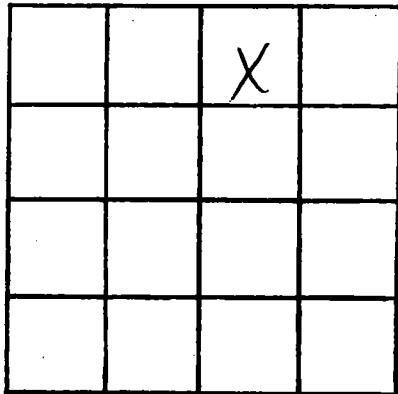

SECTION _____

Please indicate well location X.

ADDITIONAL INFORMATION

If more than one screen, show locations of each on sketch.