

MISSISSIPPI DEPARTMENT OF NATURAL RESOURCES
Bureau of Land and Water Resources
 Southport Mall
 P.O. Box 10631
 Jackson, Mississippi 39209
WATER WELL DRILLERS LOG

CODED

HARRISON
LD 296

12-19 86 ARNER DRG. SEC. HARRISON
 date well completed firm name county well located

LANDOWNER: CITY OF
LONG BEACH
LONG BEACH, MS.
 (mailing address)
 WELL LOCATION: SEA NEAR SUFF
 sec. 12 T. 8 N. R. 12 E.
 (S) (W)
 _____ miles _____ of _____
 (distance) (direction) (nearest town)

WELL PURPOSE:
 (home, Irrigation, municipal, Industrial)

WELL COMPLETION DATA:
 (1) diameter (inches) 16
 (2) total depth (feet) 862
 (3) static water level (feet) _____ below above
 top of ground.
 (4) casing STEEL, 768,
 (material) (depth)
16"
 (size) If telescope see back.
 (5) screen 72 ft., 1778+822
 (length) (depth to top)
10, 304 S.S. (.01
 (size) (material)
 (6) pump 100 1000
 (HP) (yield gpm)
Fluct.
 (type power)
 (7) electric log Yes
 (yes or no)
Miss. Geol. Survng
 (organization running log)
 (8) how well bottom plugged 7 ft string
I B. B. W. W. W.

description of formations encountered	from	to
SAND	0	22
CLAY	22	43
SAND	43	54
CLAY, BLUE	54	63
SAND + GRAVEL	63	82
CLAY	82	482
SAND	482	496
CLAY	496	572
SAND	572	596
CLAY	596	694
SAND + CLAY STRS.	694	772
SAND, Fine	772	808
CLAY	808	820
SAND	820	862
CLAY	862	878
SAND	878	892
CLAY	892	1002

CODED

RECEIVED


MAY 28 1987

Department of Natural Resources
 Bureau of Land & Water Resources

DRILLERS REMARKS:

If well telescopes please sketch and show depths.

GROUND LEVEL

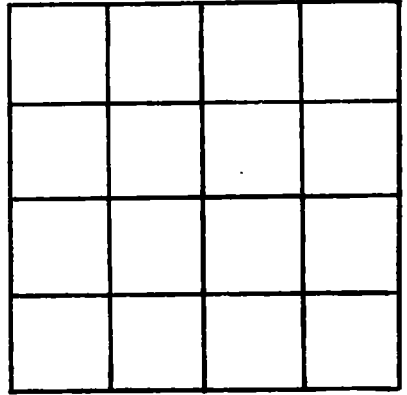

SECTION _____

Please indicate well location X.

ADDITIONAL INFORMATION

If more than one screen,
show locations of each on sketch.