

MISSISSIPPI DEPARTMENT OF NATURAL RESOURCES

Bureau of Land and Water Resources

Southport Mall

P.O. Box 10631

Jackson, Mississippi 39209

WATER WELL DRILLERS LOG

HARRISON  
 297  
 7-29-86

CODED.

7/29/86 Lyman Well Harrison  
 date well completed firm name county well located

LANDOWNER

The Clendon Building  
1639 22nd Ave  
Gulfport, MS 39501  
 (mailing address)

Description of formations encountered

from to

<u>Top soil</u>			<u>1'</u>
<u>Sandy Clay</u>		<u>1'</u>	<u>6'</u>
<u>Sand</u>		<u>6'</u>	<u>21'</u>
<u>White Clay</u>		<u>21'</u>	<u>28'</u>
<u>Grey Clay</u>		<u>28'</u>	<u>34'</u>
<u>Sand</u>		<u>34'</u>	<u>62'</u>
<u>Blue Clay</u>		<u>62'</u>	<u>107'</u>
<u>Sand</u>		<u>107'</u>	<u>118'</u>
<u>Blue Clay</u>		<u>118'</u>	<u>224'</u>
<u>Sand</u>		<u>224'</u>	<u>232'</u>
<u>Blue Clay</u>		<u>232'</u>	<u>384'</u>
<u>Sand</u>		<u>384'</u>	<u>396'</u>

WELL LOCATION:

sec. 6 T. 8 N. R. 12 E  
6 miles N of P.C.  
 (distance) (direction) (nearest town)

WELL PURPOSE: Home  
 (home, irrigation, municipal, industrial)

WELL COMPLETION DATA:

- (1) diameter (inches) 2"
- (2) total depth (feet) 396'
- (3) static water level (feet) 2 <sup>below</sup> above top of ground.
- (4) casing PVC, 396'  
 (material) (depth)  
2"  
 (size) if telescope see back.
- (5) screen 10', 386'  
 (length) (depth to top)  
2", PVC  
 (size) (material)
- (6) pump 1, 15  
 (HP) (yield gpm)  
electric  
 (type power)
- (7) electric log No  
 (yes or no)  
No  
 (organization running log)
- (8) how well bottom plugged sand  
Shark

CODED

RECEIVED


OCT 28 1986

Department of Natural Resources  
 Bureau of Land & Water Resources

DRILLERS REMARKS: None

If well telescopes please sketch and show depths.

GROUND LEVEL

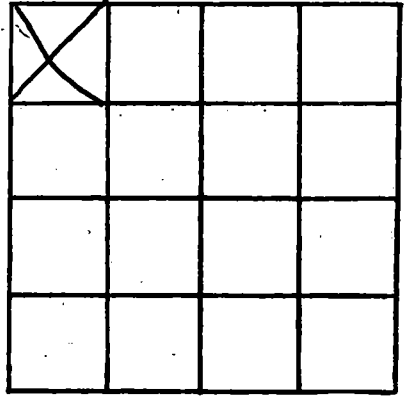

SECTION 60

Please indicate well location X.

ADDITIONAL INFORMATION

If more than one screen,  
show locations of each on sketch.