

MISSISSIPPI DEPARTMENT OF ENVIRONMENTAL QUALITY

Office of Land and Water Resources

COUNTY WELL LOCATED
Harrison

WELL NUMBER *Q-356* CODED

DATE WELL COMPLETED
5-21-58

PERMIT NUMBER
0404GW15154

NAME OF DRILLING FIRM
Lyman well co

P. O. Box 10631
Jackson, MS 39289-0631
WATER WELL DRILLERS LOG

NAME & MAILING ADDRESS OF LANDOWNER
Sutter Water Service
397 Clark Avenue
Pass Christian Ms 39571

WELL LOCATION SEC TOWNSHIP RANGE
 17 *8* *N* *12* *E*

DISTANCE DIRECTION NEAREST TOWN
2 Miles *N* of *Long Beach*

OTHER LANDMARK

WELL PURPOSE: Home, Irrigation, Municipal, Industrial, Fish Pond, etc.

PUMP DATA

PUMP TYPE (Circle One):
Submersible, Turbine, Jet, Flowing Well,
Other (Describe) _____

POWER TYPE (Circle One):
Electric, Tractor, Diesel, Gasoline, Butane,
Other (Describe) _____ H/P _____

Pump Capacity (GPM)	No. of Stages	Setting Depth
<i>250</i>	<i>4</i>	<i>105</i> FT.

PUMP TEST

Well yielded *300* GPM with
a drawdown of *18* ft.
after *24* hours of pumping

WELL DATA

Well Depth <i>518</i>	Casing Diameter (In.) <i>8</i>	Casing Length (Ft.) <i>440</i>
Type of Casing <i>Steel</i>	Hole Depth <i>518</i>	Depth to Static Water Level <i>26</i>

TYPE OF COMPLETION: (Circle One or More):
Gravel Packed, Underreamed, Telescoped,
Natural Development, Open Hole, Other
(Describe) _____

LOG DATA

TYPE OF LOG RUN (Circle One):
Electric, Gamma Ray, Density, Sonic, Neutron,
Other (Describe) *stake*

Name of Organization Running Log

WELL GROUTED TO A DEPTH OF *440* FEET
Type Grout (circle one): Cement, Bentonite, or Mix

GEOLOGIC DATA (Office Use Only)

Surface Elev.	Geologic Unit	Unit Thickness	Depth to Top
Subs. SWL	Date	Analysis	Aquifer Test

Driller's Remarks

Top of Lap Pipe or Reduction in Casing

FEET IF TELESCOPED OR MORE THAN ONE SCREEN: USE BACK PAGE


SCREEN DATA

Diameter - Inches <i>4"</i>	Length - Feet <i>50'</i>	Slot Size - Inches <i>.10</i>
Screen Type <i>SS</i>	Depth to Bottom - Feet <i>518</i>	

DESCRIPTION OF FORMATIONS ENCOUNTERED	FROM	TO	FORMATIONS (Continued)	
			FROM	TO
			<i>Whit Sand</i>	<i>25'</i>
			<i>Blue Clay</i>	<i>480'</i>
			<i>Sand</i>	<i>578'</i>
			RECEIVED	
			APR 11 2001	
			Dept of Environmental Quality	
			Office of Land & Water Resources	
			IF MORE SPACE IS NEEDED, USE BACK	

If well telescopes please sketch and show depths.

GROUND LEVEL

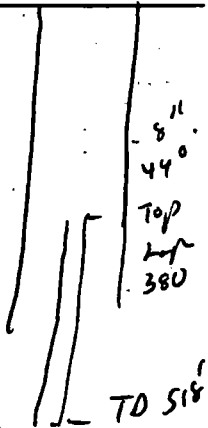

			^

SECTION _____

Please indicate well location X.

ADDITIONAL INFORMATION

SE/4, NE/4, NW/4, SW/4.

36° 20' 45" N 89° 12' 17" W

If more than one screen,
show location of each on sketch.