

MISSISSIPPI DEPARTMENT OF ENVIRONMENTAL QUALITY

Office of Land and Water Resources

P. O. Box 10631
Jackson, MS 39289-0631
WATER WELL DRILLERS LOG

COUNTY WELL LOCATED
Harrison

WELL NUMBER 7-300 CODED

DATE WELL COMPLETED
MAY 10

PERMIT NUMBER
M+M Well

NAME OF DRILLING FIRM
8827 Boss Well
Bilbo MS

NAME & MAILING ADDRESS OF LANDOWNER
Fred Bilbo
11263 Montebella

Latitude:
Longitude:

WELL LOCATION: SEC 18 TOWNSHIP 8S RANGE 12W

DISTANCE 2 Miles DIRECTION South of NEAREST TOWN Lawville

OTHER LANDMARK
Industrial Sewing

WELL PURPOSE: Home, Irrigation, Municipal, Industrial, Fish Pond, etc.
Home

PUMP DATA

PUMP TYPE (Circle One):
 Submersible, Turbine, Jet Flowing Well,
Other (Describe) _____

POWER TYPE (Circle One):
 Electric, Tractor, Diesel, Gasoline, Butane,
Other (Describe) _____ H/P _____

DESCRIPTION OF FORMATIONS ENCOUNTERED	FROM	TO
<u>Sand</u>	<u>0</u>	<u>100</u>
<u>grey clay</u>	<u>100</u>	<u>160</u>
<u>green clay</u>	<u>160</u>	<u>380</u>
<u>Sand</u>	<u>380</u>	<u>440</u>

WELL DATA

Well Depth <u>440</u>	Casing Diameter (In.) <u>4X2</u>	Casing Length (Ft.) <u>425</u>
Type of Casing <u>PVC</u>	Hole Depth <u>440</u>	Depth to Static Water Level <u>25'</u>

TYPE OF COMPLETION: (Circle One or More):
 Gravel Packed, Underreamed, Telescoped,
 Natural Development, Open Hole, Other
(Describe) _____

WELL GROUTED TO A DEPTH OF 10 FEET
Type Grout (circle one): Cement, Bentonite, or Mix

SCREEN DATA

Diameter - Inches <u>2"</u>	Length - Feet <u>15'</u>	Slot Size - Inches <u>1006</u>
Screen Type <u>PVC 40</u>	Depth to Bottom - Feet <u>425-440</u>	

RECEIVED

JUN 23 2003

BY: OLWR

Top of Lap Pipe or Reduction in Casing

FEET IF TELESCOPED OR MORE THAN ONE SCREEN: USE BACK PAGE

I certify that the well was drilled, constructed and completed in accordance with all applicable Requirements of the Mississippi Department of Environmental Quality and/or the Mississippi Department of Health regulations and state laws.


Sh. M. Old 0563
Signature of Licensed Driller and License No.

Jun 22, 2003
Date

Additional Information Required On Back

If well telescopes please sketch and show depths.

GROUND LEVEL

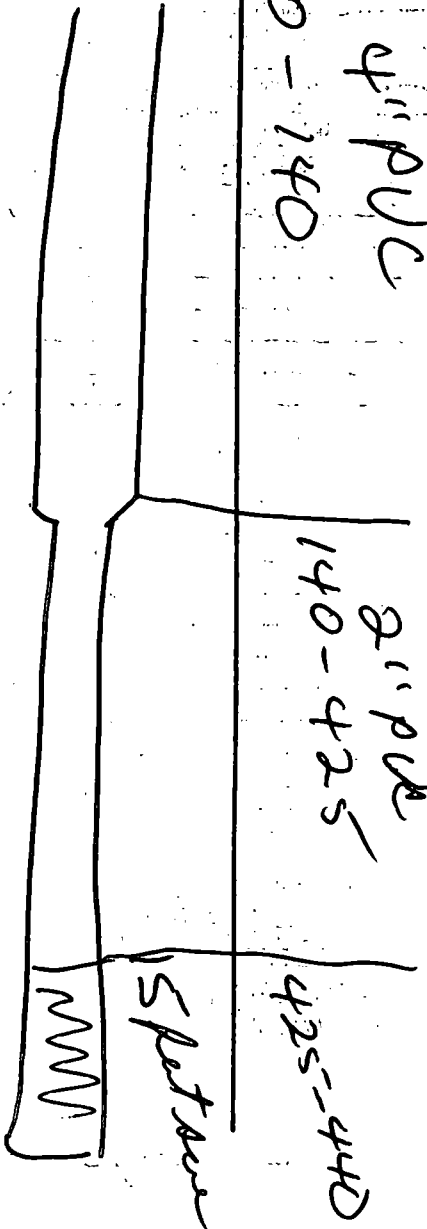

		X	

SECTION 18

Please indicate well location X.

Pump Capacity (GPM)	No. of Stages	Setting Depth
20	9	60 FT.

PUMP TEST

Well yielded 35 GPM with
 a drawdown of 40 ft.
 after _____ hours of pumping

LOG DATA

TYPE OF LOG RUN (Circle One): No Log Run, Electric, Gamma Ray, Density, Sonic, Neutron, Other (Describe) _____

Name of Organization Running Log _____

GEOLOGIC DATA (Office Use Only)

Surface Elev.	Geologic Unit	Unit Thickness	Depth to Top
Subs. SWL	Date	Analysis	Aquifer Test

Driller's Remarks

If more than one screen, show location of each on sketch.