

State Well Report

Part 1

Mississippi Department of Environmental Quality
Office of Land and Water Resources
P.O. Box 10631
Jackson, MS 39289-0631
(601)961-5210
(601)354-6938 (fax)

For Office Use Only:

Aquifer: _____
Well #: ~~φ~~ 374
L. S. Elevation: _____
E-log #: _____

County: Harris 047
Permit #: 0239
Driller: McGill Pump & Well
Date drilling completed: 09/07/04

McGill Pump and Well

State Law requires that this report be prepared by the driller in detail and filed with the Department within 30 days of completion of drilling of the well.

Well Owner Information	Well Location
Owner Name: <u>Marvin Waaga</u>	Latitude: _____ Longitude: _____
Mailing Address: <u>5225 Espy Ave</u>	Method of Lat/Long (circle one): <input checked="" type="checkbox"/> Conventional Survey, <input type="checkbox"/> USGS quad, <input type="checkbox"/> Hand-held GPS, <input type="checkbox"/> Survey-grade GPS
<u>L.B.</u> <u>Ms.</u> <u>39560</u>	<u>1/4</u> <u>1/4</u> Sec <u>8</u> Twn <u>85</u> Rng <u>R12W</u>
City State Zip Code	Distance Direction Nearest Town
Telephone No. <u>(228) 452-7145</u>	<u>2</u> Miles <u>E</u> of <u>P.C.</u>

Well Data

Purpose of Well (circle one) Home Industrial Public Supply Irrigation Fish Culture Other: _____

Date well drilling started: 09/06/04 Date well drilling completed: 09/07/04

If flowing, method of flow regulation: Valve _____ Other (describe) _____

Static Water Level: 20 feet above or below (circle one) land surface Date measured: 09/07/04

Method of Measurement (circle one) steel tape electric tape air line other: _____

Hole depth: 460 Well depth: 460 Well grouted to a depth of 10 feet

Type of grout (circle one): Cement Bentonite Mix

Casing length: 440 feet Casing diameter: 2 inches Type of casing: PVC

Screen length: 20 feet Screen diameter: 2 inches Type of screen: PVC

Screen slot size: .0006 inches Setting depth: From 440 feet to 460 feet

Type of completion (circle all applicable): Gravel packed Underreamed Telescoped Open hole Natural Development

Other (describe): _____

Top of lap pipe or reduction in casing: 2 feet. If telescoped or more than one screen, describe on back of page

Logs run (circle all applicable): No log run Electric Gamma Ray Density Sonic Neutron Other: _____

Name of organization running log(s): _____

RECEIVED
SEP 20 2004
BY: OLWR

I certify that the well was drilled, constructed, and completed in accordance with all applicable requirements of the Mississippi Department of Environmental Quality and/or the Mississippi Department of Health regulations and state laws.

McGill Pump & Well 0239
Print Name of Water Well Contractor and License No.

Mike McNeil
Signature of Water Well Contractor

If well telescopes please sketch below and show depths.

Ground Level

~~0~~ 374


Description of Formations Encountered

From To

Description of Formations Encountered	From	To
SAND	30	80
MUD	80	160
SAND	180	200
MUD	200	420
SAND	420	460

If more than one screen, show location of each on sketch

Sketch the property layout and include the following: 1) the well location; 2) any permanent structures on the property that may aid in locating the well; 3) any roads, power lines, or other items that may aid in locating the property and the well; 4) indicate direction.

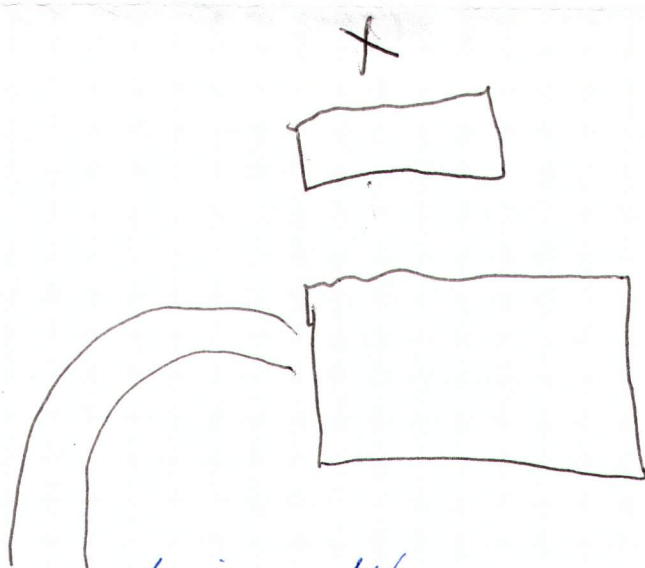

RECEIVED
 SEP 20 2004
 BY: OLWR
 RECEIVED
 SEP 20 2004
 BY: OLWR

Landowner Name: Marion Waaga

Michel McSill
 Signature of Water Well Contractor

STATE WELL REPORT

Part 2

Pump Installer's Completion Report
 Mississippi Department of Environmental Quality
 Office of Land and Water Resources
 P.O. Box 10631
 Jackson, MS 39289-0631
 (601)961-5210
 (601)354-6938 (fax)

For Office Use Only:

Aquifer: _____
 Well #: 374
 Elevation: _____

County: Harrison
 Permit #: 0239
 Driller: McGill Pump & Well
 Date completed: 09/07/04

This report should be prepared by the pump installer in detail and filed with the Department within 30 days of the installation of pump.

Well Owner Information	Well Location
Owner Name: <u>Marian Waaga</u>	Latitude: _____ Longitude: _____
Mailing Address: <u>5225 Espy Ave</u>	Method of Lat/Long (circle one): Conventional Survey, USGS quad, Hand-held GPS, Survey-grade GPS
<u>L.B.</u> <u>Ms.</u> <u>39560</u>	_____ ¼ _____ ¼ Sec <u>8</u> Twn <u>85</u> Rng <u>12 W</u>
City State Zip Code	Distance Direction Nearest Town
Telephone No. <u>(228) 452-2145</u>	<u>9</u> Miles <u>E</u> of <u>P.C.</u>

Pump Type Circle one	Power Type Circle one
Air Lift Jet Submersible	Diesel Engine Gasoline Engine Natural Gas
Bucket Piston Turbine	Electric Motor Hand Tractor PTO
Centrifugal Rotary Flowing Well	Windmill Other (specify): _____
Other (specify): _____	Horse Power Rating of Motor: _____
Date Pump Installed: _____	Setting Depth: _____ feet
Rated Pump Capacity: _____ Gallons Per Minute	Number of Stages: _____

Pump Test Data	Method of Measuring Water Level Circle one
Date Well Tested: _____	<u>Air Line</u> Electric Measuring Line Steel Tape
Static Water Level (A): _____ Feet Below Land Surface	Other (specify): _____
Pumping Water Level (B): _____ Feet Below Land Surface	For flowing well, measured shut in head: _____ feet
Drawdown [(B) - (A)]: _____ Feet Below Land Surface	Well yielded <u>20</u> GPM with a drawdown of
Test Pumping Rate: _____ Gallons Per Minute	<u>10</u> feet after <u>1</u> hours of pumping
Duration of Pump Test (minimum 4 hours): _____ hours	

RECEIVED
SEP 20 2004
BY: OLWR

I HEREBY CERTIFY that the above statements are true to the best of my knowledge.

McGill Pump & Well 0239 _____
 Print Name of Pump Installer and License No. (if applicable) Signature of Pump Installer