

HAR.

MISSISSIPPI BOARD OF WATER COMMISSIONERS

(?)

2000  
6-10-62

WATER WELL DRILLERS LOG

Date: 6-10, 1962, Driller: C. T. SWITZER WELL CO. County: Harrison

(Name)

(1) Owner of Land: L. C. Payne  
(Name)  
Daughtery Rd., Long Beach  
(Address)

(2) Location: 1/4, 1/4, Sec. 4 T. 8. R. 12  
(distance) (direction) (Nearest Town)

(3) Topography:  Level  
(Hilly) (Flat) (Level)

(4) Purpose of Well: Domestic  
(Domestic Irrigation  
Municipal, Industrial, Other)

Description & Color of Materials Sand, Clay, Red Clay, Shell, etc.	Thick- ness Feet	Depth Feet
Clay	08	05
Sand	05	41
Clay	41	71
Sand	71	81
Sand & Gravel	81	101
Sand	101	116
Clay	116	361
Sand & Shale	361	381
Clay	381	538
Sand	538	581

Information upon completion of well:

(1) Diameter 2" inches.


(2) Total Depth 578 feet.

(3) Water Level 1' feet below top of ground.

(4) Cased to 578', Size 2"

(5) Screen: Size 2", Length 10'

(6) Were any formations sealed against pollution?  
 yes,  no.

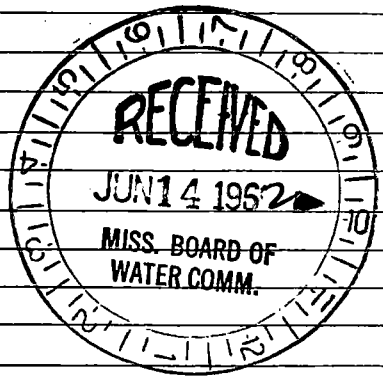

If YES depth of formation \_\_\_\_\_

Why Health Dept. Requirement

Drillers Remarks: \_\_\_\_\_

Retain this copy for your office files.

(Use Back Side)

Well No.

~~SECRET~~

SECRET

11-109  
11-110  
11-111  
11-112  
11-113  
11-114  
11-115  
11-116

SECRET  
SECRET  
