

HAR.

MISSISSIPPI BOARD OF WATER COMMISSIONERS

~~11-10-62~~ 11-10-62

2008 379918

WATER WELL DRILLERS LOG

Date: 9-10, 1962, Driller: C. T. SWITZER WELL CO. County: Harrison

(Name)

(1) Owner of Land: C. R. Pender
(Name)

(Address)

(2) Location: 1/2 Sec. 18 R 42
_____ miles _____ of _____
(distance) (direction) (Nearest Town)

(3) Topography: (Hilly) (Flat) (Level)

(4) Purpose of Well: Domestic
(Domestic Irrigation
Municipal, Industrial, Other)

Description & Color of Materials Sand, Clay, Red Clay, Shell, etc.	Thick- ness Feet	Depth Feet
Clay	00	06
Sand	06	54
Clay	54	65
Sand	65	85
Clay	88	151
Sand	151	166
Clay	166	186
Clay & sand str.	186	206
Clay	206	216
Clay and shell	216	267
Clay	267	287
Sand	287	299
Clay	299	318
Clay & shell	318	368
Sand, fine	368	387
Clay	387	449
Sand str.	449	469
Sand, fine	469	489
Clay	489	495
Sand	495	507
Clay	507	516
Clay	516	553
Sand	553	618

Information upon completion of well:

(1) Diameter 4 x 3 inches.

(2) Total Depth 618' feet.

(3) Water Level 29' + feet below top of ground.

(4) Cased to 618', Size 4 x 3"


(5) Screen: Size 4 x 3", Length 30'

(6) Were any formations sealed against pollution?
 yes, no.

If YES depth of formation _____

Why Health Dept. Requirements

Drillers Remarks: _____

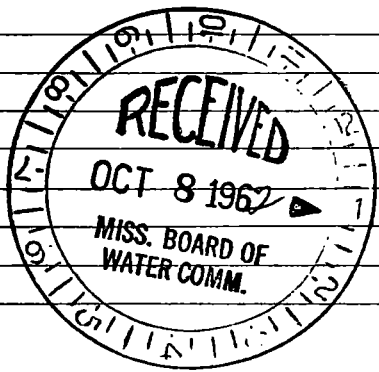

(Use Back Side)

Well No.

