

0 2007

3-26-64

WATER WELL DRILLERS LOG

C. T. SWITZER WELL CO.

Date: 3-26, 1964, Driller: \_\_\_\_\_ County: Washington

(Name)

(1) Owner of Land: J. A. Radmire  
(Name)  
Daughtery Rd. Long Beach  
(Address)

(2) Location: \_\_\_\_\_ 1/4, \_\_\_\_\_ 1/4, Sec. 4 T R/2  
 \_\_\_\_\_ miles \_\_\_\_\_ of \_\_\_\_\_  
(distance) (direction) (Nearest Town)

(3) Topography:  Hilly  Flat  Level

(4) Purpose of Well: Domestic  
(Domestic Irrigation Municipal, Industrial, Other)

Description & Color of Materials Sand, Clay, Red Clay, Shell, etc.	Thick- ness Feet	Depth Feet
Clay	10	20
Sand	20	50
Clay	50	120
Clay w/ few sand strbs	120	140
Clay	140	230
Sand	230	240
Sand, gravel	240	260

Information upon completion of well:

(1) Diameter 2 inches.

(2) Total Depth 260 feet.

(3) Water Level: 5 1/2' feet below top of ground.

(4) Cased to 260', Size 2"


(5) Screen: Size 2", Length 10'

(6) Were any formations sealed against pollution?  
 yes, \_\_\_\_\_ no.

If YES depth of formation \_\_\_\_\_

Why Health Dept. requirements

Drillers Remarks: \_\_\_\_\_

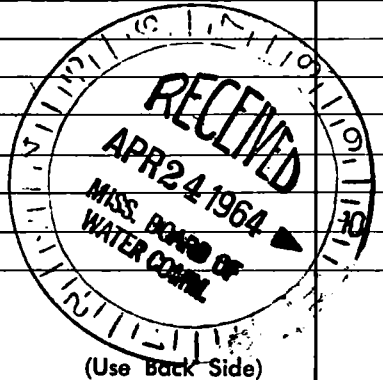

Well No.

