

HAR. MISSISSIPPI BOARD OF WATER COMMISSIONERS

0 2008

3-2-65 WATER WELL DRILLERS LOG

Date: Mar 2, 1965, Driller: Joe Miller County Harrison
 (Name)

(1) Owner of Land: Almo Kalderate
 (Name)
Long Beach Miss
 (Address)

(2) Location: 1/4, 1/4, Sec. 12 T 8 R 12
1/4 miles of Long Beach
 (distance) (direction) (Nearest Town)

(3) Topography: Flat
 (Hilly) (Flat) (Level)

(4) Purpose of Well: Domestic
 (Domestic Irrigation
 Municipal, Industrial, Other)

Description & Color of Materials Sand, Clay, Red Clay, Shell, etc.	Thick- ness Feet	Depth Feet
Surface	5	5
Black Sd. Wh Sd	19	24
Sand & Clay Mix. Blu	26	50
Blk Cl (Hard)	190	240
Gray Sand (Fine)	15	255
Blk Cl	163	420
Gray Sd. (Fine)	12	432
" " Better	10	442
" " Fair	6	448
Hard Blue Clay		452

Information upon completion of well:


- (1) Diameter 2 inches.
- (2) Total Depth 452' feet.
- (3) Water Level 5' feet below top of ground.
- (4) Cased to 438', Size 2"
- (5) Screen: Size 2", Length 10'
- (6) Were any formations sealed against pollution?
 yes, no.

If YES depth of formation _____

Why _____

Drillers Remarks: _____

5' Tail Pipe

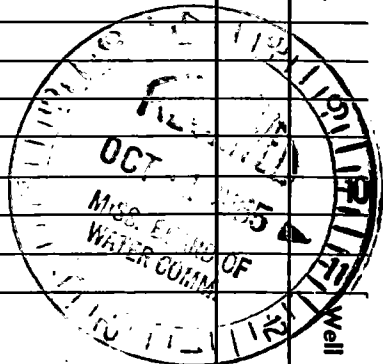

(Use Back Side)

Well No.

Beach i n n n n

HK4 90

Long Beach

Kondiko Pd

Almo
Kaledenata
↓

5512
1112

Commission Pk