

HARRISON
 2015
 5-13-76

MISSISSIPPI
 BOARD OF WATER COMMISSIONERS
 416 North State Street
 Jackson, Mississippi 39201

WATER WELL DRILLERS LOG
 COASTAL DRILLING & SERVICE CO.

ROUTE 1 BOX 618
 BILOXI, MISS. 39532

Harrison
 county well located

LANDOWNER: *Mr. Richard*

| description of formations encountered | from | to |
|---------------------------------------|------|-----|
| top soil | 1 | 3 |
| black sand | 3 | 15 |
| white sand | 15 | 40 |
| shells | 40 | 45 |
| soft blue clay | 45 | 50 |
| shells | 50 | 56 |
| soft blue clay | 56 | 170 |
| fine water sand | 170 | 225 |
| soft blue clay | 225 | 240 |
| shells | 240 | 250 |
| hard blue clay | 250 | 310 |
| coarse water sand | 310 | 340 |

PO Box 640
Long Beach, Miss
 (mailing address)

WELL LOCATION:
 sec. *16* T *2* N R *12* E
 S W
Long Beach
 (distance) (direction) (nearest town)

WELL PURPOSE: *home*
 (home, irrigation, municipal, industrial)

WELL COMPLETION DATA:

- (1) diameter (inches) 2"
- (2) total depth (feet) 340'
- (3) static water level (feet) 20 below top of ground.
- (4) casing PVC, 330'
 (material) (depth)
 (size) If telescope see back.
- (5) screen 10', 330'
 (length) (depth to top)
2", PVC
 (size) (material)
- (6) pump one 15
 (HP) (yield gpm)
ele
 (type power)
- (7) electric log no
 (yes or no)
 (organization running log)

(8) how well bottom plugged 2" black sand


DRILLERS REMARKS:

RECEIVED
 MAY 26 1976

MISS. BD. OF WATER COMMISSIONERS

If well telescopes please sketch and show depths.

GROUND LEVEL

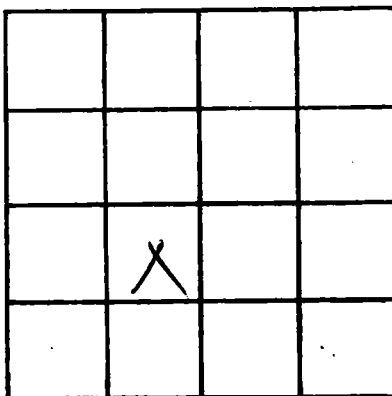

SECTION _____

Please indicate well location X.

ADDITIONAL INFORMATION

Lined area for additional information.

If more than one screen, show locations of each on sketch.