

HARRISON  
 2016  
 5/28/76

MISSISSIPPI  
 BOARD OF WATER COMMISSIONERS  
 416 North State Street  
 Jackson, Mississippi 39201

WATER WELL DRILLERS LOG

5/28/76 date well completed 1976 firm name Finewell Well Inc Harrison county well located

LANDOWNER: Jim Bishop  
L. B.  
Long Beach  
 (mailing address)

description of formations encountered	from	to
<u>fine sand</u>	<u>0</u>	<u>30</u>
<u>soft blue clay</u>	<u>20</u>	<u>130</u>
<u>red m. clay</u>		
<u>white bluish clay</u>	<u>130</u>	<u>260</u>
<u>hard blue pipe clay</u>	<u>260</u>	<u>400</u>
<u>crystal bluish white sand</u>	<u>400</u>	<u>450</u>

WELL LOCATION:  
 sec. 12 T. 8 N. R. 2 W.  
3/4 miles N of L.B.  
 (distance) (direction) (nearest town)

WELL PURPOSE: home  
 (home, irrigation, municipal, industrial)

- WELL COMPLETION DATA:
- (1) diameter (inches) 2
  - (2) total depth (feet) 450
  - (3) static water level (feet) 8 below top of ground.
  - (4) casing PVC (material), 450 (depth)  
2 (size) If telescope see back.
  - (5) screen 10 (length), 440 (depth to top)  
2 (size), PVC (material)
  - (6) pump 1 (HP), 15 (yield gpm)  
elec (type power)
  - (7) electric log ✓ (yes/no)
  - (organization running log)
  - (8) how well bottom plugged Basal  
shut


DRILLERS REMARKS:

**RECEIVED**  
 FEB 11 1977

MISS. BD. OF WATER COMMISSIONERS

If well telescopes please sketch and show depths.

GROUND LEVEL

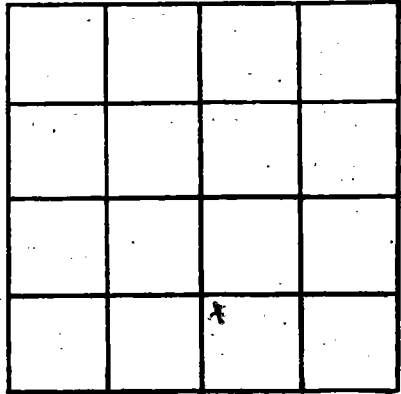

SECTION \_\_\_\_\_

Please indicate well location X.

ADDITIONAL INFORMATION

If more than one screen, show locations of each on sketch.