

HARRISON  
 2017  
 7-15-76

MISSISSIPPI  
 BOARD OF WATER COMMISSIONERS  
 416 North State Street  
 Jackson, Mississippi 39201

WATER WELL DRILLERS LOG

15 July 1976 BRYANT Well No. HARRISON  
 date well completed firm name county well located

LANDOWNER: F.M. Brown  
 P.O. Box 427  
 Pass Christian Ms.  
 (mailing address) 39571

WELL LOCATION:  
 sec. 19 T. 8 N. R. 12 E.  
 3 miles NE Pass Christian  
 (distance) (direction) (nearest town)

WELL PURPOSE: HOME  
 (home, irrigation, municipal, industrial)

WELL COMPLETION DATA:

(1) diameter (inches) 2"  
 (2) total depth (feet) 257'  
 (3) static water level (feet) 3' above top of ground.  
 (4) casing PVC, 252'  
 (material) (depth)  
 (size) If telescope see back.  
 (5) screen 5', 252'  
 (length) (depth to top)  
 08, PVC  
 (size) (material)  
 (6) pump (HP) (yield gpm)  
 Elect  
 (type power)  
 (7) electric log NO  
 (yes or no)  
 (organization running log)  
 (8) how well bottom plugged Material SAND SHARK


description of formations encountered	from	to
Clay	0	5
sand	5	25
Clay	25	50
sand	50	108
Clay	108	125
sand	125	180
Clay	180	193
fine sand	193	210
Clay	210	216
sand	216	230
Clay	230	257
good sand		

RECEIVED  
 SEP - 2 1976

DRILLERS REMARKS:

If well telescopes please sketch and show depths.

GROUND LEVEL

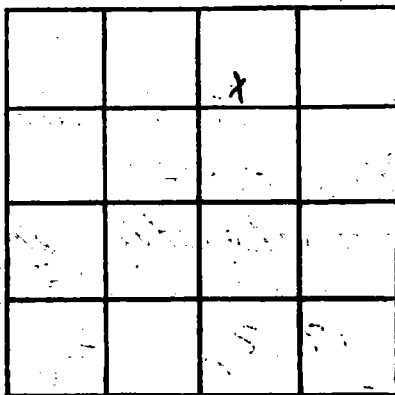

SECTION 19

Please indicate well location X.

ADDITIONAL INFORMATION

If more than one screen, show locations of each on sketch.