

Harrison
 2018
 8-17-76

MISSISSIPPI
 BOARD OF WATER COMMISSIONERS
 416 North State Street
 Jackson, Mississippi 39201

WATER WELL DRILLERS LOG

17 Aug 1976 BRYANT Well Co HARRISON
 date well completed firm name county well located


LANDOWNER: <u>GE. HOWE</u>	description of formations encountered	from	to
149 PINEVILLE Rd			
<u>LONG BEACH, Miss.</u> (mailing address)	clay	0	5
WELL LOCATION: sec <u>6</u> T <u>8</u> N R <u>12</u> <u>3</u> miles <u>N,W</u> of <u>LONG BEACH</u> (distance) (direction) (nearest town)	sand	5	36
WELL PURPOSE: <u>HOME</u> (home, irrigation, municipal, industrial)	clay	36	41
WELL COMPLETION DATA: (1) diameter (inches) <u>2"</u>	sand	41	67
(2) total depth (feet) <u>535'00"</u>	clay	67	112
(3) static water level (feet) <u>20</u> below top of ground.	sand	112	118
(4) casing <u>PVC</u> , <u>525</u> (material) (depth)	clay	118	210
<u>10</u> If telescope see back. (size)	sand	210	225
(5) screen <u>10</u> , <u>525</u> (length) (depth to top)	clay	225	300
<u>08</u> , <u>PVC</u> (size) (material)	sand	300	321
(6) pump <u>NONE</u> (HP) (yield gpm)	clay	321	378
(type power)	fine sand	378	384
(7) electric log <u>NO</u> (yes or no)	clay	384	428
(organization running log)	sand	428	437
(8) how well bottom plugged <u>Metal SAND SHANK</u>	clay	437	470
DRILLERS REMARKS:	fine sand	470	510
	good sand	510	535

RECEIVED
 SEP - 2 1976

MISS. BD. OF WATER COMM

If well telescopes please sketch and show depths.

GROUND LEVEL

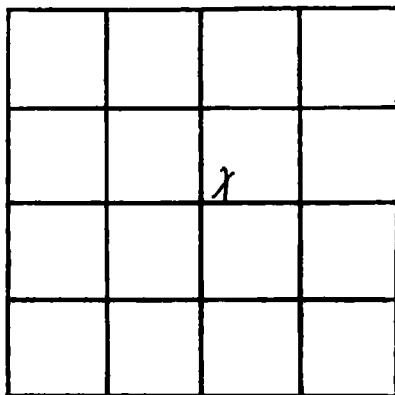

SECTION B6

Please indicate well location X.

ADDITIONAL INFORMATION

If more than one screen,
show locations of each on sketch.