

HARRISON
 2021
 11/20/76

MISSISSIPPI
 BOARD OF WATER COMMISSIONERS
 416 North State Street
 Jackson, Mississippi 39201

WATER WELL DRILLERS LOG
 COASTAL DRILLING & SERVICE CO.

11/20 date well completed 1976 ROUTE 1 BOX 618 firm name
 BILOXI, MISS 39532 county well located *Harrison*

LANDOWNER: *L O Huddell*
 Rt 1 Box 101A
 Long Beach Miss
 (mailing address)

WELL LOCATION:
 sec 3 T 8 N R 12 E
 S W
 11 one miles North Long Beach
 (distance) (direction) (nearest town)

WELL PURPOSE: *home*
 (home, irrigation, municipal, industrial)

- WELL COMPLETION DATA:
- (1) diameter (inches) 4 1/2"
 - (2) total depth (feet) 500'
 - (3) static water level (feet) 20 below above top of ground.
 - (4) casing PVC 545'
 (material) (depth)
4 1/2" If telescope see back.
 (size)
 - (5) screen 15' 545'
 (length) (depth to top)
2" PVC
 (size) (material)
 - (6) pump One 1/2 30
 (HP) (yield gpm)
S/e
 (type power)
 - (7) electric log no
 (yes or no)

(organization running log)
 (8) how well bottom plugged 2"
no bottom valve

DRILLERS REMARKS:

| description of formations encountered | from | to |
|---------------------------------------|------------|------------|
| <i>Top Soil</i> | | <i>5</i> |
| <i>White Sand</i> | <i>5</i> | <i>80</i> |
| <i>Red Clay</i> | <i>80</i> | <i>100</i> |
| <i>Green Sand</i> | <i>100</i> | <i>125</i> |
| <i>Soft Blue Clay</i> | <i>125</i> | <i>310</i> |
| <i>fine water sand</i> | <i>310</i> | <i>325</i> |
| <i>hard Blue Clay</i> | <i>325</i> | <i>490</i> |
| <i>fine water sand</i> | <i>490</i> | <i>510</i> |
| <i>Coarse Water Sand</i> | <i>510</i> | <i>500</i> |

RECEIVED
 FEB 4 1977

MISS. BD. OF WATER COMMISSIONERS

If well telescopes please sketch and show depths.


GROUND LEVEL

160' 4" PVC
Casing

385' 2" PVC
Casing

15' 2" PVC Screen
2" Lock Wash
Valve

If more than one screen,
show locations of each on sketch.

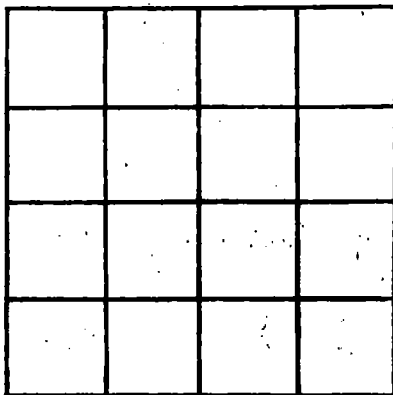

SECTION _____

Please indicate well location X.

ADDITIONAL INFORMATION

Multiple horizontal lines for additional information.