

Harrison
 P 2031
 6/18/77

MISSISSIPPI
 BOARD OF WATER COMMISSIONERS
 416 North State Street
 Jackson, Mississippi 39201

WATER WELL DRILLERS LOG

6/18 1977 *Grubbs Well in Harrison*
 date well completed firm name county well located

LANDOWNER: *David Cobb*
Loy Beach


description of formations encountered	from	to
<i>fine sand</i>	<i>0</i>	<i>40</i>
<i>soft fine sandy</i>	<i>40</i>	<i>160</i>
<i>shale</i>		
<i>white pipe clay</i>	<i>160</i>	<i>240</i>
<i>soft blue clay</i>	<i>240</i>	<i>420</i>
<i>fine sand</i>	<i>420</i>	<i>460</i>
<i>hard blue clay</i>	<i>460</i>	<i>590</i>
<i>cone sand</i>	<i>590</i>	<i>640</i>

(mailing address)
 WELL LOCATION:
 sec. *11* T. *8* N. R. *12* W.
3 miles *NW* of *S.B.M.*
 (distance) (direction) (nearest town)

WELL PURPOSE: *16 in*
 (home, irrigation, municipal, industrial)

- WELL COMPLETION DATA:
- (1) diameter (inches) *2"*
 - (2) total depth (feet) *640*
 - (3) static water level (feet) *13* below top of ground.
 - (4) casing *PVC*, *640*
 (material) (depth)
2 If telescope see back.
 (size)
 - (5) screen *18*, *625*
 (length) (depth to top)
2, *PVC*
 (size) (material)
 - (6) pump *1*, *12*
 (HP) (yield gpm)
E/C
 (type power)
 - (7) electric log *N*
 (yes or no)
 - (organization running log)
 - (8) how well bottom plugged *to 2*
blunt

DRILLERS REMARKS: *Pump in 120ft from well fully water at 12:00*

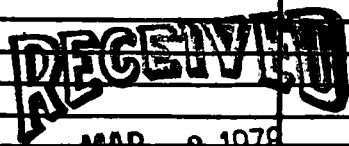

MAR - 3 1978

MISS. BD. OF WATER COMM

If well telescopes please sketch and show depths.

GROUND LEVEL

SECTION _____

Please indicate well location X.

ADDITIONAL INFORMATION

If more than one screen, show locations of each on sketch.