

Harrison
 Ø 2039
 10/5/77

MISSISSIPPI
 BOARD OF WATER COMMISSIONERS
 416 North State Street
 Jackson, Mississippi 39201

WATER WELL DRILLERS LOG

10-5-77
 date well completed

BRYANT WELL CO. HARRISON
 firm name county well located

LANDOWNER: R.T. Griger
 Rt 1 Box 89-K
 Long Beach Mo.
 (mailing address)

description of formations encountered	from	to
clay	0	32
clay	32	42
clay	42	52
clay	52	59
clay	59	111
clay	111	121
clay	121	121
fine sand	170	18
clay	184	24
light sand	245	25
fine clay	256	26
good sand	361	42

WELL LOCATION:
 sec. 5 T. 6 (N) R. 12 (W)
 S (W)
 miles - 10 of (distance) (direction) (nearest town)

WELL PURPOSE: (home, irrigation, municipal, industrial)

WELL COMPLETION DATA:
 (1) diameter (inches) 3"
 (2) total depth (feet) 423'
 (3) static water level (feet) 5' below top of ground.
 (4) casing PVC 217' (material) (depth)
 If telescope see back.
 (size) 10"
 (5) screen 423' 423' (length) (depth to top)
 109' PVC (size) (material)
 (6) pump (HP) (yield gpm)
 (type power)
 (7) electric log No (yes or no)
 (organization running log)
 (8) how well bottom plugged No
 SAND SPARK


DRILLERS REMARKS:

RECEIVED
 JAN 19 1978

MISS. BD. OF WATER COMM

If well telescopes please sketch and show depths.

GROUND LEVEL

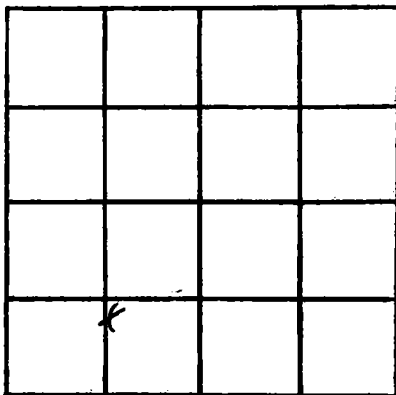

SECTION 5

Please indicate well location X.

ADDITIONAL INFORMATION

If more than one screen, show locations of each on sketch.