

HARRISON
 0 2041
 3-26-78

MISSISSIPPI
 BOARD OF WATER COMMISSIONERS
 416 North State Street
 Jackson, Mississippi 39201

WATER WELL DRILLERS LOG

3/26/78 19 Boatell Drilling Harrison
 date well completed film name county well located
Baldwin Miss

LANDOWNER: P.A. Wells

description of formations encountered	from	to
top soil	1	3
Red Clay	3	15
Coarse white sand	15	60
Soft Blue Clay	60	230
fine white sand	230	320
peat	320	325
fine water sand	325	340
hard blue clay	340	505
fine water sand	505	525
coarse water sand	525	580

Rt 1 Box 126
 Long Beach, Miss
 (mailing address)

WELL LOCATION:

sec. 3 T. 8 N. R. 12 E.
 (1/3) mil. North of Long Beach (distance) (direction) (nearest town)

WELL PURPOSE: home
 (home, irrigation, municipal, industrial)


WELL COMPLETION DATA:

- (1) diameter (inches) 2"
- (2) total depth (feet) 580'
- (3) static water level (feet) 4' below top of ground.
- (4) casing PVC 570'
 (material) (depth)
 (size) if telescope see back.
- (5) screen 10' 570
 (length) (depth to top)
2" PVC
 (size) (material)
- (6) pump One Set 20
 (HP) (yield gpm)
1/2 hp
 (type power)
- (7) electric log no
 (yes or no)

(organization running log)

(8) how well bottom plugged
2" hard wood valve

DRILLERS REMARKS:

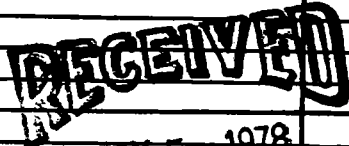

MAY 5 - 1978

MISS. BD. OF WATER COMM

If well telescopes please sketch and show depths.

GROUND LEVEL

	X		

SECTION _____

Please indicate well location X.

ADDITIONAL INFORMATION

If more than one screen, show locations of each on sketch.