

HARRISON

MISSISSIPPI  
BOARD OF WATER COMMISSIONERS  
416 North State Street  
Jackson, Mississippi 39201

0 242

5-31-78

WATER WELL DRILLERS LOG

5/3/78  
date well completed

Coastal Drilling  
Dr. R. B. Smith  
firm name

Harrison  
county well located

LANDOWNER:

John  
Tutentocher

description of formations  
encountered

from to

Jory Beckman  
(mailing address)

Top Soil	1	4
Barren Sand	4	15
Red Clay	15	3.5
Sandy Sand	35	60
M. White Sand	60	90
Soft Blue Clay	90	315
Free Water Sand	315	340
Hard Blue Clay	340	440
Free Water Sand	440	450
Good Water Sand	450	485

WELL LOCATION:

sec. 9 T. 2 N. R. 12 E.  
S W  
1/2 mile North Jory Beckman  
(distance) (direction) (nearest town)

WELL PURPOSE:

home  
(home, irrigation, municipal, industrial)

WELL COMPLETION DATA:

- (1) diameter (inches) 2"
- (2) total depth (feet) 485'
- (3) static water level (feet) 10 below above ground.
- (4) casing PVC 425'  
(material) (depth)
- (size) If telescope see back.
- (5) screen 10' 425'  
(length) (depth to top)
- 2" PVC  
(size) (material)
- (6) pump One Sep 20  
(HP) (field gpm)
- 440  
(type power)
- (7) electric log no  
(yes or no)

(organization running log)

(8) how well bottom plugged

2" beach with gravel

DRILLERS REMARKS:


RECEIVED

JUL 18 1978

MISS. BD. OF WATER COMMISSIONERS

If well telescopes please sketch and show depths.

GROUND LEVEL

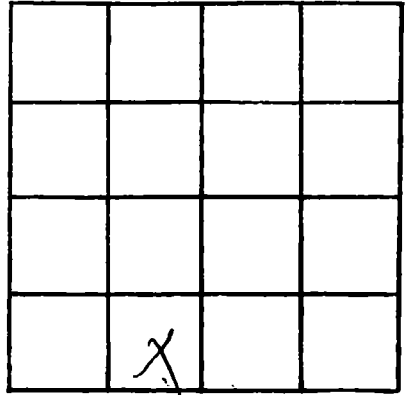

SECTION \_\_\_\_\_

Please indicate well location X.

ADDITIONAL INFORMATION

If more than one screen,  
show locations of each on sketch.