

HARRISON
 02043
 3-6-78

MISSISSIPPI
 BOARD OF WATER COMMISSIONERS
 416 North State Street
 Jackson, Mississippi 39201

WATER WELL DRILLERS LOG

March 6 1978 *Tuman Well Drilling Harrison*
 date well completed firm name county well located

LANDOWNER: *Samuel McLaughlin*
Beatrice Rd. Rt. 1 Box 65
Long Beach, Mo.
 (mailing address)

description of formations encountered	from	to
	<i>Clay</i>	<i>0</i>
<i>Sand</i>	<i>10</i>	<i>30</i>

WELL LOCATION:
 sec. *9* T. *8* N. R. *12* E.
3 miles *SW* of *Long Beach*
 (distance) (direction) (nearest town)

WELL PURPOSE: *Tuman Well*
 (home, irrigation, municipal, industrial)

- WELL COMPLETION DATA:
- (1) diameter (inches) *2"*
 - (2) total depth (feet) *30'*
 - (3) static water level (feet) *10* below above
top of ground.
 - (4) casing *PVC* *20'*
(material) (depth)
 _____ If telescope see back.
(size)
 - (5) screen *10'* *20'*
(length) (depth to top)
2" *PVC SCH. 40*
(size) (material)
 - (6) pump *None*
(HP) (yield gpm)
(type power)
 - (7) electric log _____
(yes or no)
(organization running log)
 - (8) how well bottom plugged *Cap*


DRILLERS REMARKS:

RECEIVED
 AUG 11 1978

MISS. BD. OF WATER COMM

If well telescopes please sketch and show depths.

GROUND LEVEL

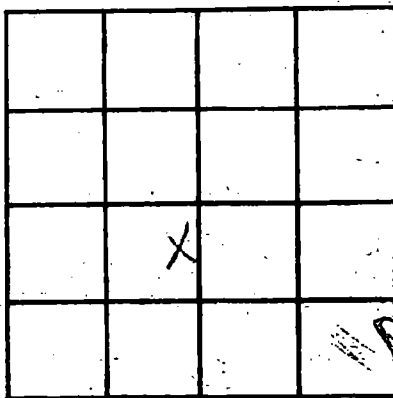

SECTION 9

Please indicate well location X.

ADDITIONAL INFORMATION

If more than one screen, show locations of each on sketch.